

Webster  
 M 18.  
 5-31-69

MISSISSIPPI  
 BOARD OF WATER COMMISSIONERS  
 416 North State Street  
 Jackson, Mississippi 39201

WATER WELL DRILLERS LOG

5-31 1969 Charles Lovorn Webster  
 date well completed firm name county well located

LANDOWNER:	description of formations encountered	from	to
John Robinson Eupora Miss (mailing address)	Red clay Blue sandstone Blue sand	0	15 15 227 246
<b>WELL LOCATION:</b> sec. 3 T19 N R 9 E S W 5 miles W of Eupora (distance) (direction) (nearest town)			
<b>WELL PURPOSE:</b> (home, irrigation, municipal, industrial)			
<b>WELL COMPLETION DATA:</b> (1) diameter (inches) 4" (2) total depth (feet) 246' (3) static water level (feet) 39' below top of ground. (4) casing Plastic, 146' (material) (depth) (size) If telescope see back. (5) screen (length) (depth to top) (size) (material) (6) pump 3/4 (HP) 7 (yield gpm) Electric (type power) (7) electric log (yes or no) (organization running log) (8) how well bottom plugged Open			


JUN 4 1969

MISS. BD. OF  
 WATER COMMISSIONERS

DRILLERS REMARKS:

If well telescopes please sketch and show depths.

GROUND LEVEL

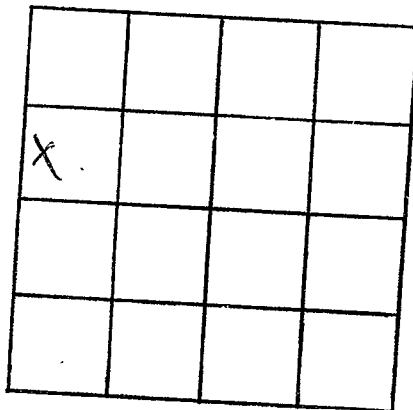

SECTION 3NE

Please indicate well location X.

ADDITIONAL INFORMATION

A series of horizontal lines for writing additional information.

If more than one screen, show locations of each on sketch.