

WEBSTER

M 19

2-28-69

MISSISSIPPI BOARD OF WATER COMMISSIONERS
416 North State Street
Jackson, Mississippi 39201

CODED

WATER WELL DRILLERS LOG

2-28-69 1969 Charles Lester Mubetis
date well completed firm name county well located

LANDOWNER:

Hollis Gary
Eupora Miss.
(mailing address)

description of formations encountered

from to

Red Clay 0 20
Blue sandstone 20 140
Blue fine sand 140 176

WELL LOCATION:

sec 29 T. 19 N. R. 9 E
S W
1 miles W of Centerville
(distance) (direction) (nearest town)

WELL PURPOSE: home
(home, irrigation, municipal, industrial)

WELL COMPLETION DATA:

(1) diameter (inches) 4"
(2) total depth (feet) 176
(3) static water level (feet) 10 below top of ground.

(4) casing plastic 140
(material) (depth)

_____ if telescope see back.
(size)

(5) screen _____
(length) (depth to top)

_____ (size) _____ (material)

(6) pump 3/4 7
(HP) (yield gpm)

Electric
(type power)

(7) electric log NO
(yes or no)

_____ (organization running log)

(8) how well bottom plugged Open


JUN 4 - 1969

DRILLERS REMARKS:

MISS. BD. OF WATER COMMS.

If well telescopes please sketch and show depths.

GROUND LEVEL

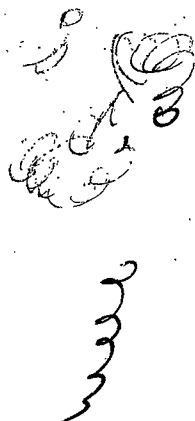

			X

SECTION 29NE

Please indicate well location X.

ADDITIONAL INFORMATION

If more than one screen, show locations of each on sketch.