

Webster
M 21
12-2-69

MISSISSIPPI
BOARD OF WATER COMMISSIONERS
416 North State Street
Jackson, Mississippi 39201

CODED
CODED

WATER WELL DRILLERS LOG

12-2-69 date well completed 1967 Charles Lovorn firm name Webster county well located

LANDOWNER: W. N. Sallee
Rt 1
Searna Miss
(mailing address)

description of formations encountered	from to	
	ft	ft
Red Clay	0	15
Blue Sandstone	15	120
Gray Sand	120	172

WELL LOCATION:
sec. 13 T. 19 N. R. 9 E
1/2 miles S. of Grady
(distance) (direction) (nearest town)

WELL PURPOSE: home
(home, irrigation, municipal, industrial)

- WELL COMPLETION DATA:
- (1) diameter (inches) 4"
 - (2) total depth (feet) 172'
 - (3) static water level (feet) 50' below top of ground.
 - (4) casing Plastic, 172' (material) (depth)
 - (size) if telescope see back.
 - (5) screen (length) (depth to top)
 - (size) (material)
 - (6) pump 3/4 (HP) 6 gpm (yield gpm)
 - Electric (type power)
 - (7) electric log NO (yes or no)
 - (organization running log)
 - (8) how well bottom plugged Grouted


JAN 14 1970

MISS. BD. OF
WATER COM. LOG

DRILLERS REMARKS:

If well telescopes please sketch and show depths.

GROUND LEVEL

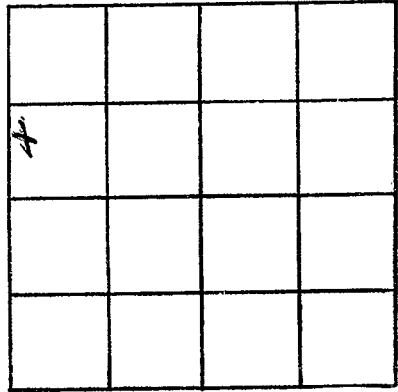

SECTION 13

Please indicate well location 'X'.

ADDITIONAL INFORMATION

If more than one screen,
show locations of each on sketch.