

GW-871

ELOG #24

WEBSTER
M25
7-9-71

MISSISSIPPI
BOARD OF WATER COMMISSIONERS
416 North State Street
Jackson, Mississippi 39201

CODED

WATER WELL DRILLERS LOG
Horton-Homan Well & Supply, Inc.

P. O. Box 42

Webster

7-9 1971
date well completed

LANOON, MISSISSIPPI 39069 county well located

LANDOWNER: Tomnolen Water Assoc.
Tomnolen, Miss.
(mailing address)

description of formations encountered	from	to
White Chalk	0	19
White Sand	19	30
Blue Rock	30	40
Rock	40	41
Blue Rock	41	58
Rock	58	59
Lime Rock	59	145
Sand	145	169
Lime Rock & Sand Struck	169	230
Lime Sand	230	300
Sand - Hard	300	365
Mudstone	365	489

WELL LOCATION:
sec. 28 T. 19 N. R. 9 E
(distance) miles (direction) of Tomnolen (nearest town)

WELL PURPOSE: Municipal
(home, irrigation, municipal, industrial)

WELL COMPLETION DATA:

(1) diameter (inches) 10 x 6

(2) total depth (feet) 365

(3) static water level (feet) 7 below top of ground.

(4) casing Steel, 300' (material) (depth)

10 (size) if telescope see back.

(5) screen 50'5" 304" (length) (depth to top)

6 Stainless (size) (material)

(6) pump 15 218 (HP) (yield gpm)

electric (type power)

(7) electric log Yes (yes or no)

USYS (organization running log)

(8) how well bottom plugged Backwash Valve 360'

CODED



AUG 4 - 1971

MISS. BD. OF WATER COMMISSIONERS

DRILLERS REMARKS:

If well telescopes please sketch and show depths.

GROUND LEVEL

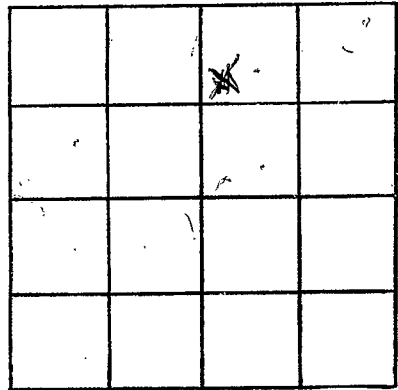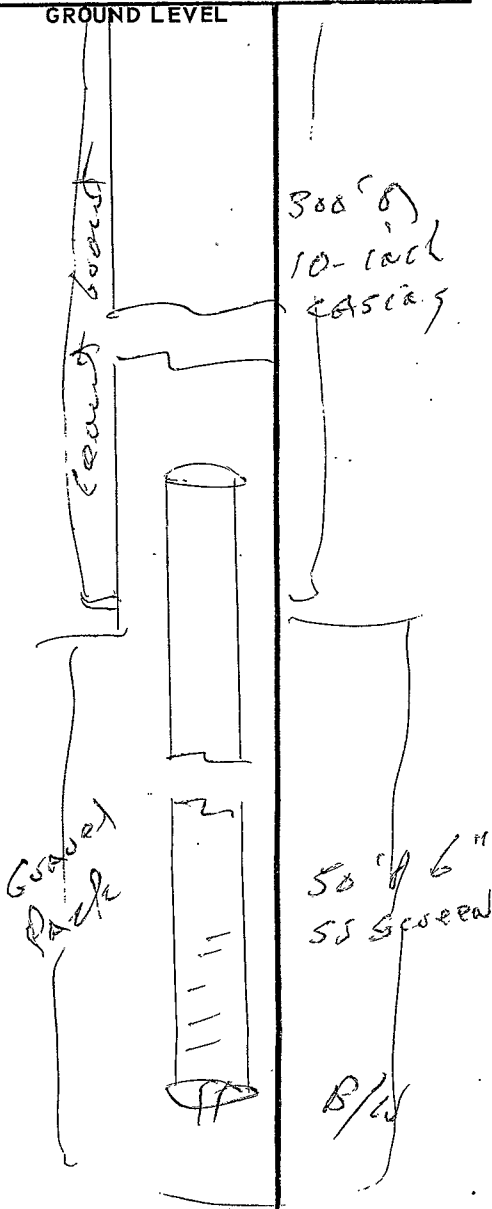

S/W NW NE/4
SECTION 28

Please indicate well location X.

ADDITIONAL INFORMATION

Bottom up
Bottom of Screen 360'
20' 2" Screen
6' Blank
30' 3" Screen
42' 11" Blank
Top of Loop 260'

If more than one screen, show locations of each on sketch.