

MISSISSIPPI DEPARTMENT OF NATURAL RESOURCES

Bureau of Land and Water Resources

Southport Mall

P.O. Box 10631

Jackson, Mississippi 39209

WATER WELL DRILLERS LOG

MONTGOMERY  
WEBSTER  
M 2000

June 20 1986  
date well completed

THOMAS DRILLING & SUPPLY CO.  
firm name

WEBSTER  
Montgomery  
county well located


LANDOWNER: Tommy Edwards  
Rt. 1 Box 233A  
Eupora, MS  
(mailing address)

description of formations encountered	from	to
<u>Yellow Sand</u>	<u>0</u>	<u>30</u>
<u>White Sand Course</u>	<u>30</u>	<u>83</u>
<u>Light Gray Sand Fine</u>	<u>83</u>	<u>120</u>
<u>Light Gray Sand Course</u>	<u>120</u>	<u>150</u>

WELL LOCATION:  
sec. 23 T-19 N R-9 E  
S W  
3 miles S of Midway  
(distance) (direction) (nearest town)

WELL PURPOSE: Home  
(home, irrigation, municipal, industrial)

- WELL COMPLETION DATA:
- (1) diameter (inches) 2"
  - (2) total depth (feet) 150'
  - (3) static water level (feet) 60' below above top of ground.
  - (4) casing PVC 150'  
(material) (depth)  
2" if telescope see back.  
(size)
  - (5) screen 10' 140'  
(length) (depth to top)  
2" PVC  
(size) (material)
  - (6) pump 1 6  
(HP) (yield gpm)  
220  
(type power)
  - (7) electric log —  
(yes or no)  
—  
(organization running log)
  - (8) how well bottom plugged cap

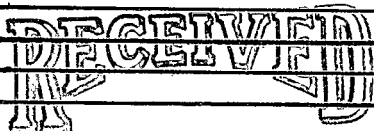


AUG 29 1986

DRILLERS REMARKS: Sand at 93 is Dry

Department of Natural Resources  
Bureau of Land & Water Resources

If well telescopes please  
sketch and show depths.

GROUND LEVEL

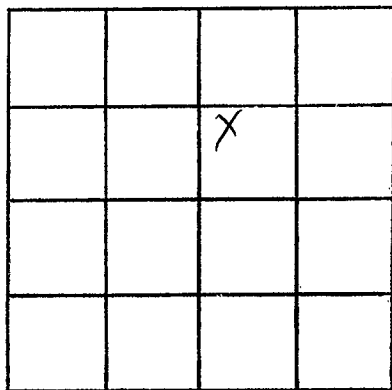

SECTION 23

Please indicate well location X.

ADDITIONAL INFORMATION

If more than one screen,  
show locations of each on sketch.