

WILKINSON  
A 7  
9-30-81

MISSISSIPPI DEPARTMENT OF NATURAL RESOURCES  
Bureau of Land and Water Resources  
Southport Mall  
P.O. Box 10631  
Jackson, Mississippi 39209  
WATER WELL DRILLERS LOG

CODED

9-30-81 date well completed      Rayborn Drill. & Const. Co. firm name      Wilkinson county well located

LANDOWNER:  
Rebel Drill. Co.  
Natchez, MS.  
(mailing address)

description of formations encountered	from	to
Top soil	0	3
Chalk	3	130
Sand	130	160
Shale	160	290
Sand	290	390

WELL LOCATION:  
sec. 32 T. 40 N. R. 3 E.  
2 miles W of Delosso  
(distance) (direction) (nearest town)

WELL PURPOSE:  
(home, irrigation, municipal, industrial)

WELL COMPLETION DATA:  
(1) diameter (inches) 3"  
(2) total depth (feet) 390'  
(3) static water level (feet) 120' below top of ground.  
(4) casing Blk., 370' (material) (depth)  
3" (size) if telescope see back.  
(5) screen 20' 370' (length) (depth to top)  
3" slotted pipe (size) (material)  
(6) pump — 42 GPM (HP) (yield gpm)  
(type power)  
(7) electric log no (yes or no)  
(organization running log)  
(8) how well bottom plugged used plug

Could not find well in old record.  
W.R.  
CODED


DEPT. OF NATURAL RESOURCES  
BUREAU OF LAND & WATER RESOURCES

OCT - 6 1981  
RECEIVED

DRILLERS REMARKS:

If well telescopes please  
sketch and show depths.

GROUND LEVEL

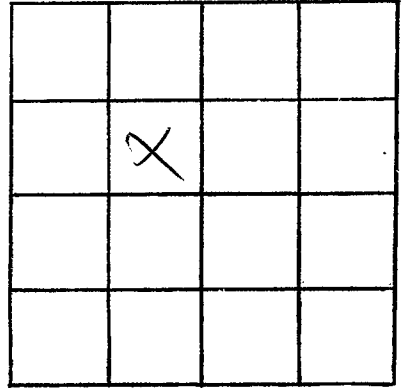

SECTION 32

Please indicate well location X.

ADDITIONAL INFORMATION

If more than one screen,  
show locations of each on sketch.