

MISSISSIPPI DEPARTMENT OF NATURAL RESOURCES
 Bureau of Land and Water Resources
 Southport Mall
 P.O. Box 10631
 Jackson, Mississippi 39209
WATER WELL DRILLERS LOG

CODED

Wilkinson
A 8
10-30-81

10-30-81 date well completed
 Rayborn Drill & Const. Wilkinson firm name
 county well located

LANDOWNER:
New & Hughes Drill Co.
Hatcher Mrs.
 (mailing address)

description of formations encountered	from	to
<u>Top Soil</u>	<u>0</u>	<u>2</u>
<u>Humus</u>	<u>2</u>	<u>37</u>
<u>Sand</u>	<u>37</u>	<u>110</u>

WELL LOCATION:
 sec. 18 T. 4 S. R. 3 E.
1 miles NW of Dalton
 (distance) (direction) (nearest town)

WELL PURPOSE:
 (home, irrigation, municipal, industrial)

- WELL COMPLETION DATA:
- diameter (inches) 3"
 - total depth (feet) 110'
 - static water level (feet) 1' below above top of ground.
 - casing Blk, 90',
 (material) (depth)
3"
 (size) If telescope see back.
 - screen 20', 90'
 (length) (depth to top)
3", slotted pipe
 (size) (material)
 - pump 520gpm
 (HP) (yield gpm)
 (type power)
 - electric log No
 (yes or no)
 (organization running log)
 - how well bottom plugged wood Plug

CODED

DEPT. OF NATURAL RESOURCES
 BUREAU OF LAND & WATER RESOURCES


NOV 2 - 1981

RECEIVED

DRILLERS REMARKS:

If well telescopes please
sketch and show depths.

GROUND LEVEL

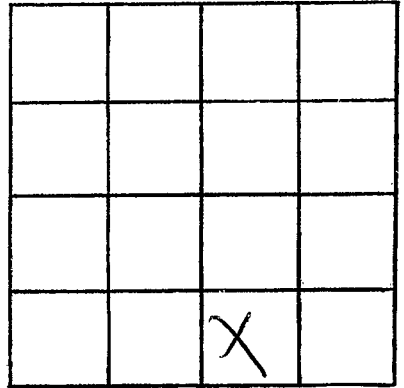

SECTION 18

Please indicate well location X.

ADDITIONAL INFORMATION

81 OCT 2 4 43

RECEIVED

If more than one screen,
show locations of each on sketch.