

Wilkinson
A9
11-11-81

MISSISSIPPI DEPARTMENT OF NATURAL RESOURCES
Bureau of Land and Water Resources
Southport Mall
P.O. Box 10631
Jackson, Mississippi 39209
WATER WELL DRILLERS LOG


CODED

11-11-81 date well completed
Rayburn Drill & Land Co. firm name
Wilkinson county well located

LANDOWNER:	description of formations encountered	from	to
Rebel Drill Company Natchez, MS 39120 (mailing address)	Top soil	0	3
WELL LOCATION: 30 sec. 22 T. 14 N. R. 3 E. S. 1 W. 2 mi. west of Nalouse (distance) (direction) (nearest town)	gumbo	3	90
WELL PURPOSE: (home, irrigation, municipal, industrial)	fine sand	90	125
WELL COMPLETION DATA:	coarse sand	125	140
(1) diameter (inches) 2"			
(2) total depth (feet) 140'			
(3) static water level (feet) 10' below top of ground.			
(4) casing Blk (material), 120' (depth)	Board of Supervisors		
3" (size) if telescope see back.	30-12-1		
(5) screen 20' (length), 120' (depth to top)	CODED		
3" (size), slotted pipe (material)			
(6) pump 50 GPM (yield gpm)			
(type power)			
(7) electric log no (yes or no)	DEPT. OF NATURAL RESOURCES BUREAU OF LAND & WATER RESOURCES		
(organization running log)	NOV 19 1981		
(8) how well bottom plugged wood plug	RECEIVED		
DRILLERS REMARKS:			

If well telescopes please
sketch and show depths.

GROUND LEVEL

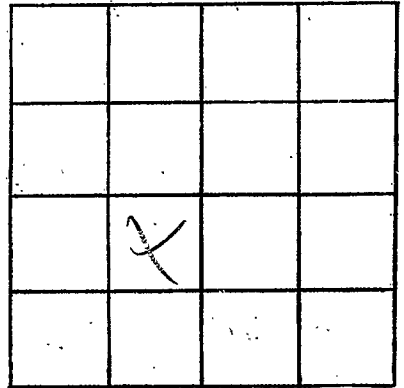

SECTION 22

Please indicate well location X.

ADDITIONAL INFORMATION

If more than one screen,
show locations of each on sketch.