

MISSISSIPPI DEPARTMENT OF NATURAL RESOURCES  
 Bureau of Land and Water Resources  
 Southport Mall  
 P.O. Box 10631  
 JACKSON, MISSISSIPPI 39209  
**WATER WELL DRILLERS LOG**

**CODED**

WILKINSON  
A-10  
2-20-82

date well completed 2-20 1982 firm name Raymond Drilling Willinson county well located \_\_\_\_\_

LANDOWNER:  
Shamrock Drilling  
Natchez Mo.  
 (mailing address)

description of formations encountered	from	to
<u>top soil</u>	<u>0</u>	<u>2</u>
<u>Chalk</u>	<u>2</u>	<u>140</u>
<u>sand</u>	<u>140</u>	<u>150</u>

WELL LOCATION:  
 sec 36 T 40 N R 3 E  
2 miles SW of Dalness  
 (distance) (direction) (nearest town)

Sharp #1

WELL PURPOSE:  
 (home, irrigation, municipal, industrial)

**CODED**

WELL COMPLETION DATA:

**CODED**

(1) diameter (inches) 3"  
 (2) total depth (feet) 150'

**CODED**

(3) static water level (feet) 20' (below top of ground)

FR. SW/CO1 See 36 go E'ly 1/4 between

(4) casing hbk 130'  
 (material) (depth)  
3" if telescope see back.  
 (size)

See 36 + 47 for 1660' th 1/4 @ RA  
335' to loc. in See 36-4N-3W

(5) screen 20' 130'  
 (length) (depth to top)  
3" slotted pipe  
 (size) (material)

(6) pump 50  
 (HP) (yield gpm)  
elc  
 (type power)

(7) electric log —  
 (yes or no)  
—  
 (organization running log)

DEPT. OF NATURAL RESOURCES  
 BUREAU OF LAND & WATER RESOURCES

(8) how well bottom plugged wood


MAR - 8 1982

DRILLERS REMARKS:

**RECEIVED**

If well telescopes please  
sketch and show depths.

GROUND LEVEL

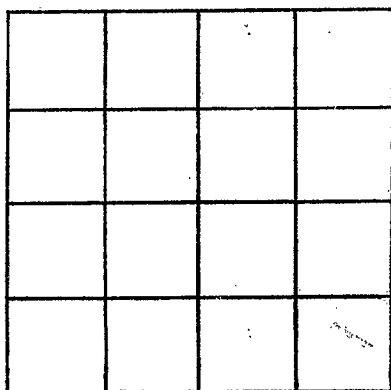

SECTION \_\_\_\_\_

Please indicate well location X.

ADDITIONAL INFORMATION

If more than one screen,  
show locations of each on sketch.