

MISSISSIPPI DEPARTMENT OF NATURAL RESOURCES
Bureau of Land and Water Resources
 Southport Mall
 P.O. Box 10631
 Jackson, Mississippi 39209
WATER WELL DRILLERS LOG

Wilkinson
All
7-7-82

304

7-7 1982 Rayborn Drilling & Const. Co. Wilkinson
 date well completed firm name county well located

LANDOWNER:	description of formations encountered	from	to
<u>O & N Drilling Co.</u>			
<u>Ferriday & Son</u> (smalling address)	<u>gumbo</u>	<u>2</u>	<u>50</u>
WELL LOCATION: sec. <u>18</u> T <u>4</u> N R. <u>3</u> E S W	<u>sand</u>	<u>50</u>	<u>130</u>
(distance) _____ miles (direction) _____ of (nearest town) _____	<u>Elevation: 60 Feet</u>		
WELL PURPOSE: <u>Oil Supply</u> (home, irrigation, municipal, industrial)	<u>0912215.311930</u>		
WELL COMPLETION DATA:			
(1) diameter (inches) <u>3"</u>	<u>for most W by Cor of Sec. 19</u>		
(2) total depth (feet) <u>130'</u>	<u>co S. 1638' th W @ RA 1896 to</u>		
(3) static water level (feet) <u>65'</u> below/above top of ground.	<u>loc in sec. 18</u>		
(4) casing <u>Alc</u> (material), <u>100'</u> (depth) <u>3"</u> (size) if telescope see back.	<u>Leake & Watson (tract #1)</u>		
(5) screen <u>30'</u> (length), <u>100'</u> (depth to top) <u>3"</u> (size), <u>slotted pipe</u> (material)			
(6) pump _____ (HP), <u>52 GPM</u> (yield gpm) _____ (type power)			
(7) electric log <u>no</u> (yes or no) _____ (organization running log)			
(8) how well bottom plugged <u>wood Plug</u>			
DRILLERS REMARKS:			


DEPT. OF NATURAL RESOURCES
 BUREAU OF LAND & WATER RESOURCES

JUL 12 1982

RECEIVED

If well telescopes please sketch and show depths.

GROUND LEVEL

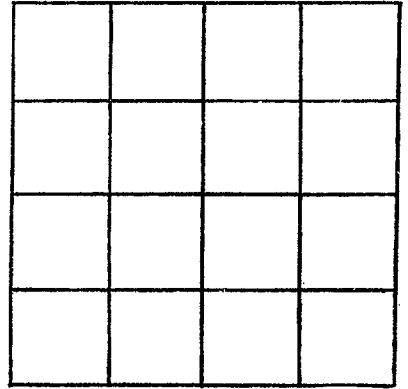

SECTION _____

Please indicate well location X.

ADDITIONAL INFORMATION

If more than one screen,
show locations of each on sketch.