

MISSISSIPPI DEPARTMENT OF NATURAL RESOURCES

Bureau of Land and Water Resources

Southport Mall

P.O. Box 10631

Jackson, Mississippi 39209

WATER WELL DRILLERS LOG

WILKINSON
A-12
1-7-83

COPY

1-7 1983 Brunfield & Wood Sr. Wilkinson
 date well completed firm name county well located

LANDOWNER:	description of formations encountered	from	to
Trace Drilling	Surface Clay	0	3'
Natchez Miss 39120 (mailing address)	Yellow Clay	3	204
	Water Sand	204	334
WELL LOCATION:			
sec. 48 T 4 N R 3 E S W (W)			
5 miles SW of Deloroso (distance) (direction) (nearest town)			
WELL PURPOSE: For Oil Well (home, irrigation, municipal, industrial)			
WELL COMPLETION DATA:			
(1) diameter (inches) 3"			
(2) total depth (feet) 332'			
(3) static water level (feet) 15' below top of ground.			
(4) casing steel, 314' (material) (depth)			
3" If telescope see back. (size)			
(5) screen 15', 314' (length) (depth to top)			
3" steel (size) (material)			
(6) pump _____ (HP) _____ (yield gpm)			
Air (type power)			
(7) electric log _____ (yes or no)			
_____ (organization running log)			
(8) how well bottom plugged Cap			

COPY

DEPT. OF NATURAL RESOURCES
 BUREAU OF LAND & WATER RESOURCES


MAR 21 1983

RECEIVED

DRILLERS REMARKS:

If well telescopes please sketch and show depths.

GROUND LEVEL

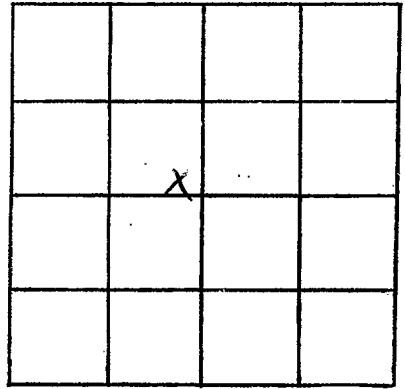

SECTION 48

Please indicate well location X.

ADDITIONAL INFORMATION

If more than one screen,
show locations of each on sketch.