

MISSISSIPPI DEPARTMENT OF NATURAL RESOURCES

Bureau of Land and Water Resources

Southport Mall

P.O. Box 10631

CODED

Jackson, Mississippi 39209

WATER WELL DRILLERS LOG

WILKINSON
A14

7/24/84 date well completed

Rayham Drilling firm name

Wilkinson county well located

LANDOWNER: Wilmer Perry, Jr.
RT 1 Box 1685
Woodville, MS 39069
(mailing address)

description of formations encountered

from to

Top Soil	0	8
Chalk	9	40
Sand	41	70
Gumbo	71	110
Sand	111	180
Gumbo	181	190
Sand	191	220

WELL LOCATION:

sec 35 T 4 N R 3 E
8 miles SW of Doras
(distance) (direction) (nearest town)

WELL PURPOSE: private
(home, irrigation, municipal, industrial)

WELL COMPLETION DATA:

- (1) diameter (inches) 4"
- (2) total depth (feet) 220'
- (3) static water level (feet) 100' below top of ground.
- (4) casing PVC pipe, 200' (material) (depth)
4" (size) if telescope see back.
- (5) screen 20', 200' (length) (depth to top)
4" PVC slotted pipe (size) (material)
- (6) pump 1 (HP) 11 (yield gpm)
(type power)
- (7) electric log NO (yes or no)
(organization running log)
- (8) how well bottom plugged wood

CODED

DEPT. OF NATURAL RESOURCES
BUREAU OF LAND & WATER RESOURCES


OCT 31 1984

RECEIVED

DRILLERS REMARKS:

If well telescopes please
sketch and show depths.

GROUND LEVEL

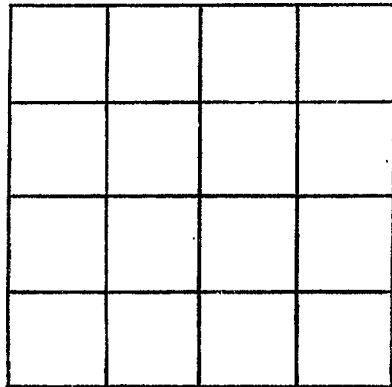

SECTION _____

Please indicate well location X.

ADDITIONAL INFORMATION

If more than one screen,
show locations of each on sketch.