

MISSISSIPPI DEPARTMENT OF NATURAL RESOURCES

Bureau of Land and Water Resources

Southport Mall

P.O. Box 10631

Jackson, Mississippi 39209

WATER WELL DRILLERS LOG

CODED

Wilkinson
A 15
11/14/84

11/14 1984 Rayborn Drilling Wilkinson
date well completed firm name county well located

LANDOWNER:
D & D Drilling Co
Ferriday, LA
(mailing address)

description of formations encountered	from	to
Top Soil	0	10
Shook	11	200
Sand	201	473

WELL LOCATION:
sec. 47 T. 4 N R. 3 E
6 miles SW of Doloroso
(distance) (direction) (nearest town)

WELL PURPOSE: oil field
(home, irrigation, municipal, industrial)

lease Name:
Page #1

- WELL COMPLETION DATA:
- (1) diameter (inches) 3"
 - (2) total depth (feet) 473'
 - (3) static water level (feet) 200' below top of ground.
 - (4) casing bk pipe 453'
(material) (depth)
 - 3" (size) if telescope see back.
 - (5) screen 20' 453"
(length) (depth to top)
 - 3" slotted pipe
(size) (material)
 - (6) pump 50
(HP) (yield gpm)
 - (type power)
 - (7) electric log YND
(yes or no)
 - (organization running log)
 - (8) how well bottom plugged good

CODED


RECEIVED
JAN 24 1985

DRILLERS REMARKS:

Department of Natural Resources
Bureau of Land & Water Resources

If well telescopes please sketch and show depths.

GROUND LEVEL

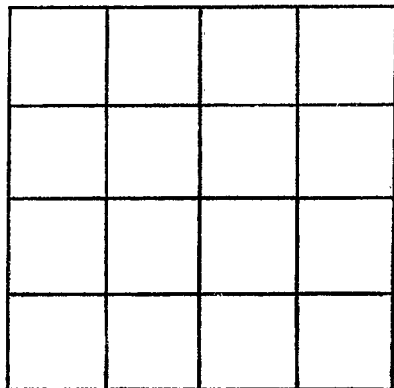

SECTION _____

Please indicate well location X.

ADDITIONAL INFORMATION

If more than one screen,
show locations of each on sketch.