

MISSISSIPPI DEPARTMENT OF NATURAL RESOURCES

Bureau of Land and Water Resources

Southport Mall

P.O. Box 10631

Jackson, Mississippi 39209

WATER WELL DRILLERS LOG

LOGGED

A 16
Wilkinson
8-19-85

8/19 1985 Rayborn Drlg Co Wilkinson
date well completed firm name county well located


LANDOWNER: <u>Rayborn Drlg Co</u>	description of formations encountered	from	to
<u>PO Box 351</u>			
<u>Ferriday LA 71334</u> (mailing address)	<u>Gumbo</u>	<u>2</u>	<u>70</u>
WELL LOCATION: sec. <u>29</u> T. <u>4</u> (N) S R. <u>3</u> E W	<u>Sand</u>	<u>70</u>	<u>115</u>
<u>4</u> miles <u>W</u> of <u>Doloroso</u> (distance) (direction) (nearest town)	<u>550'S + 500'E of NW1/4</u>		
WELL PURPOSE: <u>oilfield</u> (home, irrigation, municipal, industrial)	<u>NW SE Sec. 29-4N-3W</u>		
WELL COMPLETION DATA:			
(1) diameter (inches) <u>3"</u>			
(2) total depth (feet) <u>115'</u>			
(3) static water level (feet) <u>5'</u> <u>below</u> above top of ground.			
(4) casing <u>PVC Pipe</u> , <u>105'</u> (material) (depth) <u>3"</u> if telescope see back. (size)	Lease Name: <u>Pettis Heirs #1</u>		
(5) screen <u>10'</u> , <u>105'</u> (length) (depth to top) <u>3"</u> , <u>PVC Slotted Pipe</u> (size) (material)			
(6) pump <u>—</u> , <u>50</u> (HP) (yield gpm) <u>electric</u> (type power)			
(7) electric log <u>no</u> (yes or no) <u>—</u> (organization running log)			
(8) how well bottom plugged <u>wood</u>			
DRILLERS REMARKS: <u>—</u>			

RECEIVED
OCT - 8 1985

Department of Natural Resources
Bureau of Land & Water Resources

If well telescopes please sketch and show depths.

GROUND LEVEL

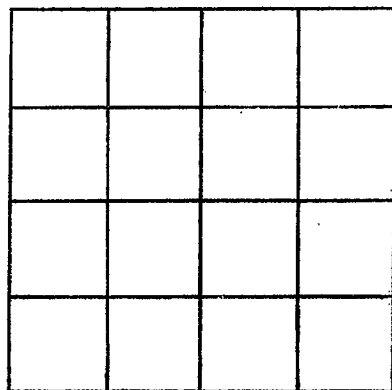

SECTION _____

Please indicate well location X.

ADDITIONAL INFORMATION

If more than one screen,
show locations of each on sketch.