

MISSISSIPPI DEPARTMENT OF NATURAL RESOURCES

Bureau of Land and Water Resources

Southport Mall

P.O. Box 10631

Jackson, Mississippi 39209

WATER WELL DRILLERS LOG

CODED

WILKINSON
A 017

9/30 1985 Rayborn Drilling Co. Wilkinson
date well completed firm name county well located

LANDOWNER: <u>DND Drilling Co.</u>	description of formations encountered	from	to
<u>PO Box 351</u>			
<u>Ferriday LA 71334</u> (mailing address)	<u>Sand</u>	<u>100</u>	<u>240</u>
WELL LOCATION: sec. <u>32</u> T. <u>40</u> N. R. <u>3</u> E. S. <u>W</u>	<u>Chalk</u>	<u>240</u>	<u>305</u>
<u>2</u> miles <u>W</u> of <u>Doloroso</u> (distance) (direction) (nearest town)	<u>Sand</u>	<u>305</u>	<u>327</u>
WELL PURPOSE: <u>oilfield</u> (home, irrigation, municipal, industrial)	<u>Chalk</u>	<u>327</u>	<u>356</u>
WELL COMPLETION DATA:	<u>Sand</u>	<u>356</u>	<u>410</u>
(1) diameter (inches) <u>3"</u>			
(2) total depth (feet) <u>410'</u>			
(3) static water level (feet) <u>100'</u> <u>below</u> above top of ground.			
(4) casing <u>blk pipe</u> , <u>390'</u> (material) (depth) <u>3"</u> If telescope see back. (size)	<u>N. NB/Cor Sec 32, 20 NW 1/4</u> <u>blk sec/L 1954, th SW 1/4</u> <u>Q RA 749'</u>		
(5) screen <u>20'</u> , <u>390'</u> (length) (depth to top) <u>3"</u> , <u>slotted blk pipe</u> (size) (material)			
(6) pump <u>—</u> , <u>50</u> (HP) (yield gpm) <u>—</u> (type power)			
(7) electric log <u>no</u> (yes or no) <u>—</u> (organization running log)			
(8) how well bottom plugged <u>wood</u>			

N. NB/Cor Sec 32, 20 NW 1/4
blk sec/L 1954, th SW 1/4
Q RA 749'


Well Name:
Davis Unit #1

APR 15 1985
Department of Natural Resources
Bureau of Land and Water Resources

DRILLERS REMARKS:

If well telescopes please
sketch and show depths.

GROUND LEVEL

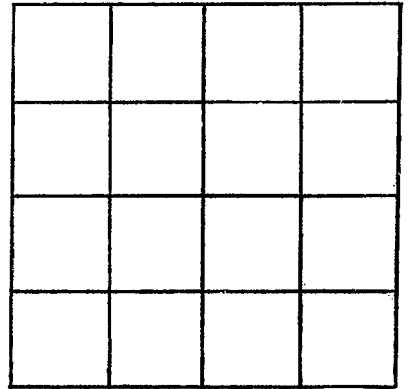

SECTION _____

Please indicate well location X.

ADDITIONAL INFORMATION

If more than one screen,
show locations of each on sketch.