

**MISSISSIPPI DEPARTMENT OF NATURAL RESOURCES**  
**Bureau of Land and Water Resources**  
 Southport Mall  
 P.O. Box 10631  
 Jackson, Mississippi 39209  
**WATER WELL DRILLERS LOG**

*Williamson*  
A 2001

12-30-1982 date well completed      *Raytheon Drilling & Const. Co.* firm name      *Williamson* county well located

LANDOWNER:	description of formations encountered	from	to
<i>Rebel Drilling Co.</i>			
<i>Natchez, ms.</i> (mailing address)	<i>Sand</i>	<i>20</i>	<i>20</i>
<b>WELL LOCATION:</b>			
sec. <i>18</i> T <i>4</i> N S R <i>3</i> E CW			
_____ miles _____ of _____ (distance) (direction) (nearest town)			
<b>WELL PURPOSE:</b> (home, irrigation, municipal, industrial)			
<b>WELL COMPLETION DATA:</b>			
(1) diameter (inches) <i>3"</i>	<i>DNE RP Unit #1</i>		
(2) total depth (feet) <i>70'</i>			
(3) static water level (feet) <i>10'</i> below/above top of ground.			
(4) casing <i>BLK</i> <i>50'</i> (material) (depth)			
<i>3"</i> (size) if telescope see back:			
(5) screen <i>20'</i> <i>50'</i> (length) (depth to top)			
<i>3"</i> (size) <i>Act. Stalled Pipe</i> (material)			
(6) pump _____ <i>52 GPM</i> (HP) (yield gpm)			
_____ (type power)			
(7) electric log <i>no</i> (yes or no)			
_____ (organization running log)			
(8) how well bottom plugged <i>wood plug</i>			
<b>DRILLERS REMARKS:</b>			


DEPT. OF NATURAL RESOURCES  
 BUREAU OF LAND & WATER RESOURCES

DEC 28 1982

**RECEIVED**

If well telescopes please sketch and show depths.

GROUND LEVEL

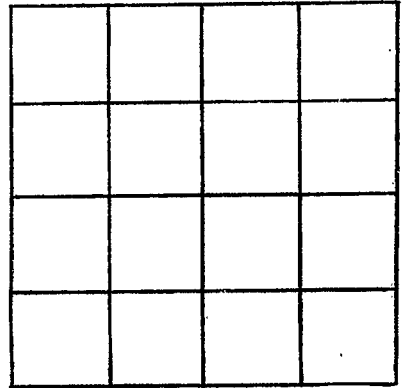

SECTION \_\_\_\_\_

Please indicate well location X.

ADDITIONAL INFORMATION

If more than one screen,  
show locations of each on sketch.