

Wilkinson  
A 2002

MISSISSIPPI DEPARTMENT OF NATURAL RESOURCES  
 Bureau of Land and Water Resources  
 Southport Mall  
 P.O. Box 10631  
 Jackson, Mississippi 39209  
**WATER WELL DRILLERS LOG**

date well completed 12-21 1982 firm name Rayborn Drilling & Const. Co. county well located Wilkinson

LANDOWNER:	description of formations encountered	from	to
<u>Wilcox Drillers</u>	<u>chault</u>	<u>0</u>	<u>117</u>
<u>Natchez, Miss.</u> (mailing address)	<u>sand</u>	<u>117</u>	<u>200</u>

WELL LOCATION:  
 sec. 18 T 4 N R 3 E  
 S W  
 (distance) miles (direction) of (nearest town)

Nuserman, Eubank #1

WELL PURPOSE:  
 (home, irrigation, municipal, industrial)

- WELL COMPLETION DATA:
- (1) diameter (inches) 3"
  - (2) total depth (feet) 200'
  - (3) static water level (feet) 100' below above top of ground.
  - (4) casing Alk. (material), 180' (depth)  
3" (size) if telescope see back.
  - (5) screen 20' (length), 180' (depth to top),  
3" (size), slotted pipe (material)
  - (6) pump — (HP), 52 GPM (yield gpm)  
— (type power)
  - (7) electric log no (yes or no)  
— (organization running log)
  - (8) how well bottom plugged wood plug

DEPT. OF NATURAL RESOURCES  
 BUREAU OF LAND & WATER RESOURCES


DEC 28 1982

RECEIVED

DRILLERS REMARKS:  
 \_\_\_\_\_  
 \_\_\_\_\_

If well telescopes please  
sketch and show depths.

GROUND LEVEL

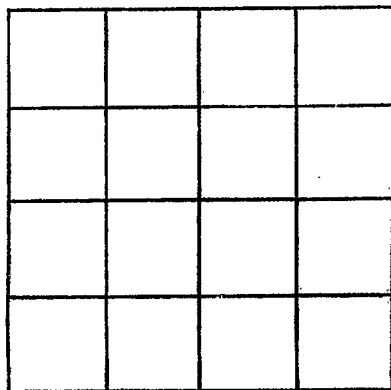

SECTION \_\_\_\_\_

Please indicate well location X.

ADDITIONAL INFORMATION

If more than one screen,  
show locations of each on sketch.