

MISSISSIPPI DEPARTMENT OF NATURAL RESOURCES
 Bureau of Land and Water Resources
 Southport Mall
 P.O. Box 10631
 Jackson, Mississippi 39209
WATER WELL DRILLERS LOG

Wilkinson
A 2003

Aug 15 1983 D S Harris & Son Drill. Co. Wilkinson
 date well completed firm name county well located

LANDOWNER: International Paper Co. Leased to Drill Well Drilling Co. Shreveport (mailing address)

description of formations encountered	from	to
<u>Sand</u>	<u>0'</u>	<u>10'</u>
<u>Clay</u>	<u>10'</u>	<u>80'</u>
<u>Sand</u>	<u>80'</u>	<u>118'</u>

WELL LOCATION:
 sec. 45 T. 4 N R. 3 E
5 miles West of DeLrose
 (distance) (direction) (nearest town)

WELL PURPOSE: Industrial
 (home, irrigation, municipal, industrial)

WELL COMPLETION DATA:

- (1) diameter (inches) 5"
- (2) total depth (feet) 118'
- (3) static water level (feet) 1' ~~below~~ above top of ground.
- (4) casing Plastic, 118'
 (material) (depth)
3" if telescope see back.
 (size)
- (5) screen 10', 108'
 (length) (depth to top)
3", Plastic
 (size) (material)
- (6) pump no pump, 200
 (HP) (yield gpm)
air compressor
 (type power)
- (7) electric log NO
 (yes or no)
 (organization running log)
- (8) how well bottom plugged _____

DRILLERS REMARKS: _____


DEPT. OF NATURAL RESOURCES
 BUREAU OF LAND & WATER RESOURCES

SEP - 6 1983

RECEIVED

If well telescopes please sketch and show depths.

GROUND LEVEL

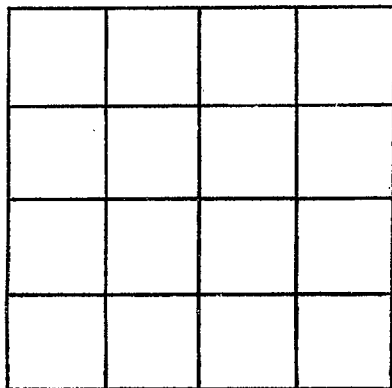

SECTION _____

Please indicate well location X.

ADDITIONAL INFORMATION

If more than one screen,
show locations of each on sketch.