

MISSISSIPPI DEPARTMENT OF NATURAL RESOURCES

Bureau of Land and Water Resources

~~Southport Mall~~

P.O. Box 10631

Jackson, Mississippi 39209

WATER WELL DRILLERS LOG

<u>WILKINSON</u>
<u>A2007</u>

9-18-1990
date well completed

Harris Well Ser.
firm name

Wilkinson Co.
county well located

LANDOWNER: Allen Rush Drilling

description of formations encountered

from to

P.O. Box 1151

Natchez, MS

(mailing address)

WELL LOCATION:

sec. 35 T 4 S R 3 E
6 miles W of Dollaroso
 (distance) (direction) (nearest town)

WELL PURPOSE: rig supply
 (home, irrigation, municipal, industrial)

WELL COMPLETION DATA:

- (1) diameter (inches) 3 in
- (2) total depth (feet) 99
- (3) static water level (feet) 6 below above
top of ground.
- (4) casing pvc, 89
(material) (depth)
3 in if telescope see back.
(size)
- (5) screen 10 ft, 89
(length) (depth to top)
- (6) pump air, pvc
(HP) (yield gpm)

(type power)
- (7) electric log No
(yes or no)

(organization running log)
- (8) how well bottom plugged pvc cap

RECEIVED
ALBRIGHT
STW


OCT 02 1990

Department of Natural Resources
 Bureau of Land & Water Resources

DRILLERS REMARKS:

If well telescopes please sketch and show depths.

GROUND LEVEL

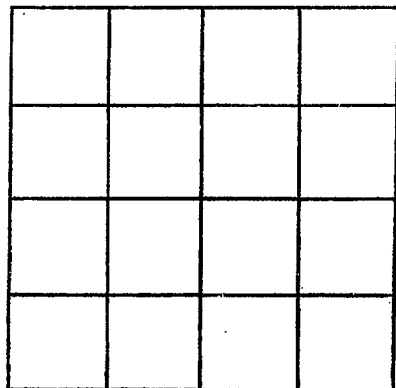

SECTION _____

Please indicate well location X.

ADDITIONAL INFORMATION

If more than one screen,
show locations of each on sketch.