

CODED

4

CODED

B1

MISSISSIPPI BOARD OF WATER COMMISSIONERS

3-25-66

WATER WELL DRILLERS LOG

Date: 3-25, 1966, Driller: Deets/Reeves, County: Wilkinson

(When well drilled)

(Name)

(Where well is located)

(1) Owner of Land (Name)	Description & Color of Materials Sand, Clay, Red Clay, Shell, etc.	Thick- ness Feet	Depth Feet
Willard Smith H-1, Woodville (Address)	shale	70	70
	soft sand	5	75
(2) Location: 1/4, 1/4, Sec. 25, T. 4 R. 2	shale	225	300
1.5 miles north of Woodville (distance) near intersection of roads	sand	70	370
(3) Topography: Hilly (Hilly) Flat (Flat) Level (Level)			
(4) Purpose of Well: Domestic (Domestic Irrigation Municipal, Industrial, Other)			

CODED


Information upon completion of well:

- (1) Diameter: 2 inches.
- (2) Total Depth: 370 feet.
- (3) Water Level: 275 feet below top of ground.
- (4) Cased to: Bottom Size 2"
- (5) Screen: Size 1 1/4, Length 6'
- (6) Were any formations sealed against pollution?
yes, no.

If YES depth of formation

Why

Drillers Remarks: red well had
Yield in gpm: Pumped 3
Size pump: 3/4 HP rod pump
Type power: Electric

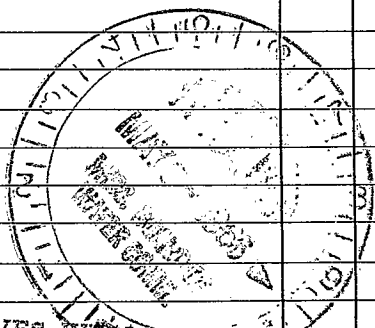

REEVES WELL & PUMP CO.
P. O. BOX 71 -- PHONE 684-1451
McCOMB, MISS.

