

WILKINSON
B 10
7-68

MISSISSIPPI
 BOARD OF WATER COMMISSIONERS
 416 North State Street
 Jackson, Mississippi 39201

CODED

WATER WELL DRILLERS LOG

7-18 1968 Central Const. Co. Wilkinson
 date well completed firm name county well located

LANDOWNER: SCOTT #1

description of formations encountered	from	to
<u>SHALE</u>	<u>0</u>	<u>145'</u>
<u>SAND</u>	<u>145'</u>	<u>175'</u>
<u>SHALE</u>	<u>175'</u>	<u>225'</u>
<u>SAND</u>	<u>225'</u>	<u>325'</u>


Matchez Drilling Co.
 (mailing address)

WELL LOCATION:
 sec 35 T 4 N R 2 E W
1 miles E of DALORISO
 (distance) (direction) (nearest town)

WELL PURPOSE: SUPPLY
 (home, irrigation, municipal, industrial)

WELL COMPLETION DATA:


- (1) diameter (inches) 3"
- (2) total depth (feet) 325'
- (3) static water level (feet) 13' below top of ground.
- (4) casing STEEL, 313,
 (material) (depth)
 (size) if telescope see back.
- (5) screen 12', 313'
 (length) (depth to top)
3", SLOTTED PIPE
 (size) (material)
- (6) pump AIR —
 (HP) (yield gpm)
ROTHNE
 (type power)
- (7) electric log NO
 (yes or no)
 (organization running log)
- (8) how well bottom plugged ADDLED CLAY

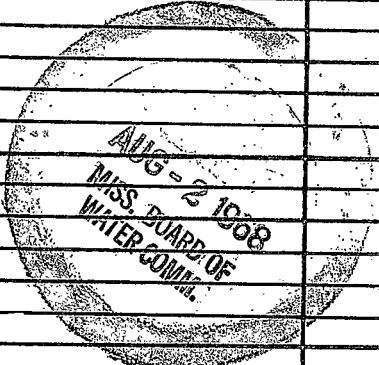

DRILLERS REMARKS:

If well telescopes please sketch and show depths.

GROUND LEVEL

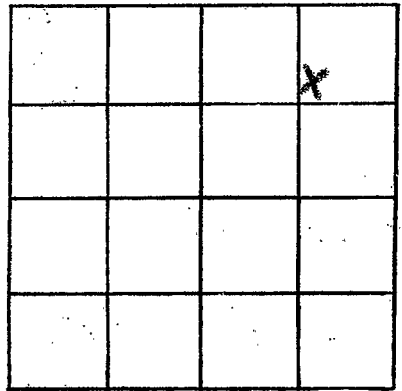

SECTION _____

Please indicate well location X.

ADDITIONAL INFORMATION

If more than one screen,
show locations of each on sketch.