

Wilkinson
B 13
6-17-70

MISSISSIPPI
 BOARD OF WATER COMMISSIONERS
 416 North State Street
 Jackson, Mississippi 39201

CODED

WATER WELL DRILLERS LOG

6-17 19 70 Griner Water Well Sec. Wilkinson
 date well completed firm name county well located

LANDOWNER:
Nardie Leake
 (mailing address)

description of formations encountered	from	to
<u>Top Soil</u>	<u>0</u>	<u>2</u>
<u>Chaultc.</u>	<u>2</u>	<u>30'</u>
<u>Smid</u>	<u>20'</u>	<u>30'</u>
<u>Shales</u>	<u>50'</u>	<u>70'</u>
<u>Sand</u>	<u>70'</u>	<u>140'</u>

WELL LOCATION:
 sec 30 T 4 N R 2 E
7 miles NE of Dolrose
 (distance) (direction) (nearest town)

WELL PURPOSE: Home
 (home, irrigation, municipal, industrial)

- WELL COMPLETION DATA:
- (1) diameter (inches) 2"
 - (2) total depth (feet) 140'
 - (3) static water level (feet) 70' below top of ground.
 - (4) casing Galv. 133'
 (material) (depth)
2" if telescope see back.
 (size)
 - (5) screen 5' 133'
 (length) (depth to top)
2" "BB"
 (size) (material)
 - (6) pump 1 1/2 76 gpm
 (HP) (yield gpm)
elec.
 (type power)
 - (7) electric log no
 (yes or no)
- (organization running log)
- (8) how well bottom plugged Washed

CODED


JUL 22 1970

DRILLERS REMARKS:

MISS. BD. OF
 WATER COMMISSIONERS

If well telescopes please sketch and show depths.

GROUND LEVEL

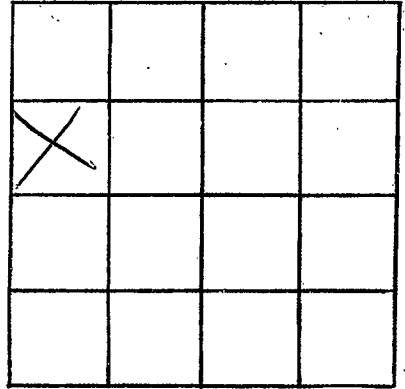

SECTION 30

Please indicate well location X.

ADDITIONAL INFORMATION

If more than one screen,
show locations of each on sketch.