

WILKINSON
 B 14
 9-24-72

MISSISSIPPI
 BOARD OF WATER COMMISSIONERS
 416 North State Street
 Jackson, Mississippi 39201

CODED

WATER WELL DRILLERS LOG

9-24 1972 Griner Water Well Service Wilkinson
 date well completed firm name county well located

LANDOWNER:
Henry Lee Smith
Delosso, Miss.
 (mailing address)

| description of formations encountered | from | to |
|---------------------------------------|------------|------------|
| <u>Top Soil</u> | <u>0</u> | <u>1</u> |
| <u>Clay</u> | <u>1</u> | <u>110</u> |
| <u>Sand</u> | <u>110</u> | <u>217</u> |

WELL LOCATION:
 sec. 17 T. 4 N R. 2 E
4 miles east of Delosso
 (distance) (direction) (nearest town)

WELL PURPOSE: Home
 (home, irrigation, municipal, industrial)

- WELL COMPLETION DATA:
- (1) diameter (inches) 2"
 - (2) total depth (feet) 217'
 - (3) static water level (feet) 127' below above top of ground.
 - (4) casing Galv. 210'
 (material) (depth)
2" If telescope see back.
 (size)
 - (5) screen 5' 210'
 (length) (depth to top)
2" "55"
 (size) (material)
 - (6) pump 2 76 gpm
 (HP) (yield gpm)
elec.
 (type power)
 - (7) electric log No
 (yes or no)
 (organization running log)
 - (8) how well bottom plugged Wood Plug

CODED


NOV 20 1972

MISS. RD. U.
 STATE ENGINEERING BOARD

DRILLERS REMARKS:

If well telescopes please sketch and show depths.

GROUND LEVEL

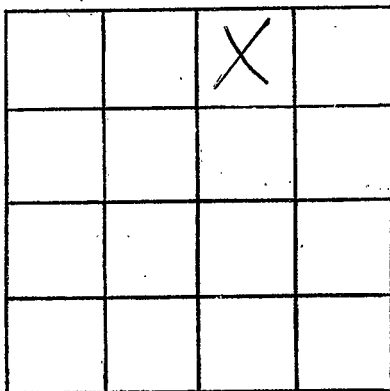

SECTION 17

Please indicate well location X.

ADDITIONAL INFORMATION

If more than one screen,
show locations of each on sketch.