

MISSISSIPPI DEPARTMENT OF NATURAL RESOURCES  
 Bureau of Land and Water Resources  
 Southport Mall  
 P.O. Box 10631  
 Jackson, Mississippi 39209  
**WATER WELL DRILLERS LOG**

**CODED**

Wilkinson  
B33  
4-29-81

Sp. 51/2" Top of well 250' W of 330  
 P. 2

4-29 <sup>1981</sup> date well completed      Rainbow Drilling & Const. Co. Wilkinson firm name      county well located

**LANDOWNER:**  
Rainbow Drilling Co.  
Natchez, Ms. 39120  
 (mailing address)

description of formations encountered	from	to
	<u>Top soil</u>	<u>0</u>
<u>Clay</u>	<u>2</u>	<u>60</u>
<u>Shale</u>	<u>100</u>	<u>135</u>

**WELL LOCATION:**  
 sec 38 T 4 N R 2 E  
3 1/2 miles South of Dobson  
 (distance) (direction) (nearest town)

<u>Sand</u>	<u>135</u>	<u>160</u>
<u>Shale</u>	<u>160</u>	<u>172</u>

**WELL PURPOSE:**  
 (home, irrigation, municipal, industrial)

<u>sand</u>	<u>172</u>	<u>193</u>
-------------	------------	------------

**WELL COMPLETION DATA:**

- (1) diameter (inches) 3"
- (2) total depth (feet) 367'
- (3) static water level (feet) 150' below top of ground.
- (4) casing BLK 367' (material) (depth)  
3" (size) if telescope see back.
- (5) screen \_\_\_\_\_ (length) \_\_\_\_\_ (depth to top)  
 \_\_\_\_\_ (size) \_\_\_\_\_ (material)
- (6) pump \_\_\_\_\_ (HP) 60 GPM (yield gpm)  
 \_\_\_\_\_ (type power)
- (7) electric log no (yes or no)  
 \_\_\_\_\_ (organization running log)
- (8) how well bottom plugged wood plug

<u>Shale</u>	<u>193</u>	<u>250</u>
<u>Sand</u>	<u>250</u>	<u>289</u>
<u>Shale</u>	<u>289</u>	<u>299</u>
<u>Sand</u>	<u>299</u>	<u>367</u>

**CODED**

DEPT. OF NATURAL RESOURCES  
 BUREAU OF LAND & WATER RESOURCES


MAY - 4 1981

**RECEIVED**

**DRILLERS REMARKS:**  
 \_\_\_\_\_  
 \_\_\_\_\_

If well telescopes please sketch and show depths.

GROUND LEVEL

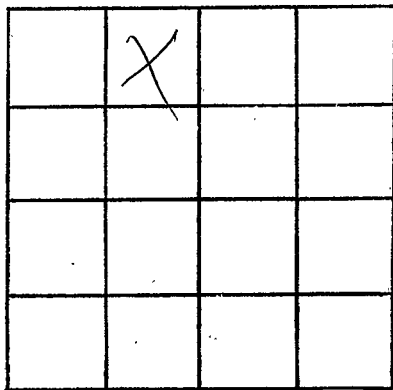

SECTION 28

Please indicate well location X.

ADDITIONAL INFORMATION

If more than one screen,  
show locations of each on sketch.