

Wilkinson  
 B 3A  
 5-18-81

MISSISSIPPI  
 BOARD OF WATER COMMISSIONERS  
 416 North State Street  
 Jackson, Mississippi 39201

CODED

WATER WELL DRILLERS LOG

May 18 1981 Grenn Water Well Cont. Wilkinson  
 date well completed firm name county well located

LANDOWNER: Cliff Marcastle  
 c/o I. Odell Anders  
 P.O. Box 745  
 Natchez, Mis.  
 (mailing address)

| description of fomations encountered | from | to  |
|--------------------------------------|------|-----|
| Loess                                | 1    | 15  |
| white clay                           | 45   | 45  |
| blue clay                            | 45   | 180 |
| sand                                 | 180  | 250 |

WELL LOCATION:  
 sec. 36 4 T N R E  
 S 2 W  
 12 miles N of Woodville  
 (distance) (direction) (nearest town)

WELL PURPOSE: home  
 (home, irrigation, municipal, industrial)

CODED

WELL COMPLETION DATA:

(1) diameter (inches) 4

(2) total depth (feet) 250

(3) static water level (feet) 150 below top of ground.

(4) casing PVC 240' (material) (depth)  
 4" (size) If telescope see back.


(5) screen 10' 240' (length) (depth to top)  
 .010 PVC (size) (material)

(6) pump 1 HP sub 8 (HP) (yield gpm)  
 electricity (type power)

(7) electric log no (yes or no)

(organization running log)

(8) how well bottom plugged back wash valve

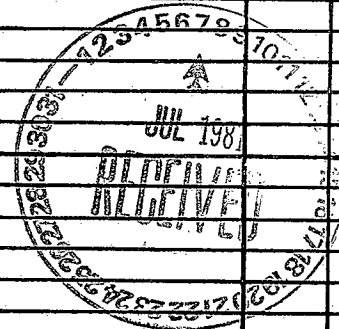

DRILLERS REMARKS:

If well telescopes please sketch and show depths.

GROUND LEVEL

|  |  |  |   |
|--|--|--|---|
|  |  |  | 7 |
|  |  |  |   |
|  |  |  |   |
|  |  |  |   |

SECTION 36

Please indicate well location X.

ADDITIONAL INFORMATION

If more than one screen, show locations of each on sketch.