

Wilkinson
B 35
8-19-81

MISSISSIPPI DEPARTMENT OF NATURAL RESOURCES
 Bureau of Land and Water Resources
 Southport Mall
 P.O. Box 10631
 Jackson, Mississippi 39209
WATER WELL DRILLERS LOG

CODED

Aug. 19 19 81 Gretn Water Well Cont. Wilkinson
 date well completed firm name county well located

LANDOWNER: Ted McCarstel
Route 1, Box 1335
Woodville, Ms. 39669
 (mailing address)

description of formations encountered	from	to
Loess	1	30
White clay	30	60
Blue Clay	60	110
sand	110	126

WELL LOCATION:
 sec. 25 4 N R 2 E
 S W
16 miles N of Woodville
 (distance) (direction) (nearest town)

WELL PURPOSE: home
 (home, irrigation, municipal, industrial)

CODED

WELL COMPLETION DATA:

(1) diameter (inches) 4

(2) total depth (feet) 126

(3) static water level (feet) 115 below above top of ground.

(4) casing PVC 116
 (material) (depth)
4" If telescope see back.
 (size)

(5) screen 10' 116'
 (length) (depth to top)
.010 PVC
 (size) (material)

(6) pump did not install
 (HP) (yield gpm)
 (type power)

(7) electric log no
 (yes or no)
 (organization running log)

(8) how well bottom plugged back wash valve

DRILLERS REMARKS:


DEPT. OF NATURAL RESOURCES
 BUREAU OF LAND & WATER RESOURCES

OCT -1 1981

RECEIVED

If well telescopes please sketch and show depths.

GROUND LEVEL

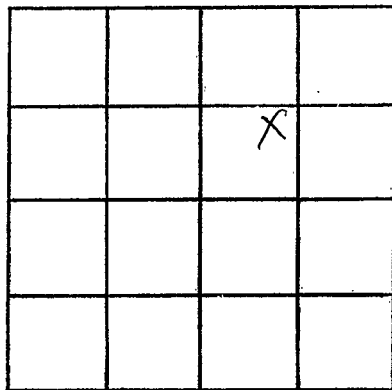

SECTION 25

Please indicate well location X.

ADDITIONAL INFORMATION

If more than one screen, show locations of each on sketch.