

WILKINSON

B 36

10/12/82

MISSISSIPPI DEPARTMENT OF NATURAL RESOURCES

Bureau of Land and Water Resources

Southport Mall

P.O. Box 10631

Jackson, Mississippi 39209

WATER WELL DRILLERS LOG

10-12-82 date well completed 1982 Rayboon Drilling & Const. Co. Wilkinson firm name Wilkinson county well located

LANDOWNER:

Rebel Drilling Co. Natchez, MS. 39120 (mailing address)

description of formations encountered

from

to

Chaultk

0

250

Sand

250

440

Chaultk

440

455

Sand

455

495

WELL LOCATION:

sec. 25 T 4 N S R 2 E W

(distance) miles (direction) of (nearest town)

From NW/Cor Sec. 24

WELL PURPOSE:

(home, irrigation, municipal, industrial)

go S along Twp/L

WELL COMPLETION DATA:

(1) diameter (inches) 2"

(2) total depth (feet) 495'

(3) static water level (feet) 180' below top of ground.

(4) casing BVC 475' (material) (depth)

2" (size) if telescope see back.

(5) screen 20' 475' (length) (depth to top)

3" slotted pipe (size) (material)

(6) pump (HP) 5.2 gpm (yield gpm)

(type power)

(7) electric log no (yes or no)

(organization running log)

(8) how well bottom plugged wood plug

2549', then E @

Framer #1

RA 1807' to

LOCATION

CODED

DEPT OF NATURAL RESOURCES BUREAU OF LAND & WATER RESOURCES


OCT 14 1982

RECEIVED

DRILLERS REMARKS:

If well telescopes please sketch and show depths.

GROUND LEVEL

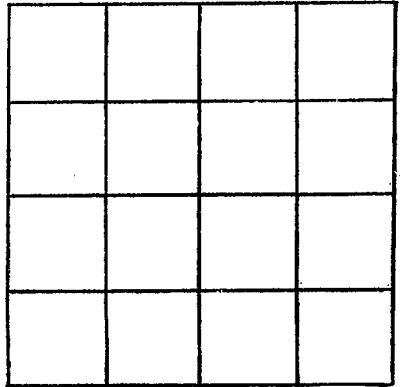

SECTION \_\_\_\_\_

Please indicate well location X.

ADDITIONAL INFORMATION

---

---

If more than one screen, show locations of each on sketch.