

WILKINSON

B 38

12/8/83

MISSISSIPPI DEPARTMENT OF

Bureau of Land and Water

Southport Mall

P.O. Box 10631

Jackson, Mississippi 39209

WATER WELL DRILLERS LOG

CODED

12-8  
date well completed

1983 Rayborn Drill & Const. Co. Wilkinson  
firm name county well located

LANDOWNER:

David New Drilling Co.

Natchez, MS 39120  
(mailing address)

description of formations encountered

Top soil

from 0 to 5

Chalk

5 275

Rat sand

275 300

sand

300 410

WELL LOCATION:

sec. 45 T 40 S R 2 E

(distance) miles (direction) of (nearest town)

WELL PURPOSE: Drinking well  
(home, irrigation, municipal, industrial)

CODED

WELL COMPLETION DATA:

(1) diameter (inches) 3"  
(2) total depth (feet) 410'

Crosby - Foster Creek 7-1

(3) static water level (feet) 180' below above top of ground.

(4) casing 3" (size) if telescope see back. Blk 390' (material) (depth)

(5) screen 20' (length) 390' (depth to top) 3" (size) slotted pipe (material)

(6) pump — (HP) 52 gpm (yield gpm) (type power)

(7) electric log no (yes or no) (organization running log)

(8) how well bottom plugged wood plug

DRILLERS REMARKS:


DEPT. OF NATURAL RESOURCES  
BUREAU OF LAND & WATER RESOURCES

DEC 12 1983

RECEIVED

scopes please  
and show depths.

GROUND LEVEL

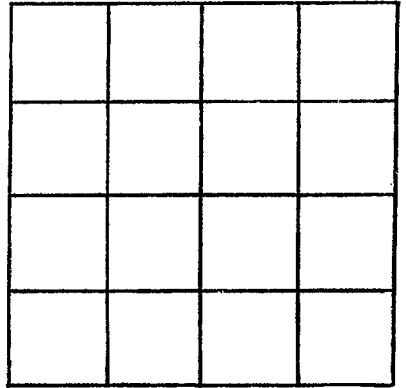

SECTION \_\_\_\_\_

Please indicate well location X.

ADDITIONAL INFORMATION

If more than one screen,  
show locations of each on sketch.