

**MISSISSIPPI DEPARTMENT OF NATURAL RESOURCES**  
 Bureau of Land and Water Resources  
 Southport Mall  
 P.O. Box 10631 **CODED**  
 Jackson, Mississippi 39209  
**WATER WELL DRILLERS LOG**

B 40  
Wilkinson  
4-30-85

4/30 1985 Rayborn Drilling Wilkinson  
 date well completed firm name county well located

LANDOWNER:	description of formations encountered	from	to
<u>Mc Moran On-Shore Exploration; P.O. Box 6800, Metairie, LA 70009</u> (mailing address)			
<b>WELL LOCATION:</b> sec. <u>37</u> T. <u>4</u> N. S. R. <u>2</u> E. W.	<u>Chalk &amp; Gumbo</u>	<u>15</u>	<u>220</u>
<u>1</u> miles <u>S</u> of <u>Dolorosa</u> (distance) (direction) (nearest town)	<u>Sand</u>	<u>220</u>	<u>230</u>
<b>WELL PURPOSE:</b> <u>oilfield</u> (home, irrigation, municipal, industrial)	<u>Gumbo</u>	<u>230</u>	<u>410</u>
<b>WELL COMPLETION DATA:</b>	<u>Sand</u>	<u>410</u>	<u>495</u>
(1) diameter (inches) <u>3"</u>			
(2) total depth (feet) <u>495'</u>			
(3) static water level (feet) <u>150'</u> <sup>(below)</sup> top of ground.			
(4) casing <u>steel</u> , <u>475'</u> (material) (depth)			
<u>3"</u> If telescope see back. (size)			
(5) screen <u>20'</u> , <u>475'</u> (length) (depth to top)			
<u>3"</u> , <u>slotted pipe</u> (size) (material)			
(6) pump <u>—</u> , <u>50</u> (HP) (yield gpm)			
(type power)			
(7) electric log <u>no</u> (yes or no)			
(organization running log)			
(8) how well bottom plugged <u>wood</u>			

Lease Name: R.B. Sharpless et al  
PT 50/CO SEC. 37 of Wilk  
only SEC/L 1748', 4th N'ly  
@ RA 1378' to top sec 37-4N-2W


**RECEIVED**  
 OCT - 8 1985

DRILLERS REMARKS:

Department of Natural Resources  
 Bureau of Land & Water Resources

If well telescopes please  
sketch and show depths.

GROUND LEVEL

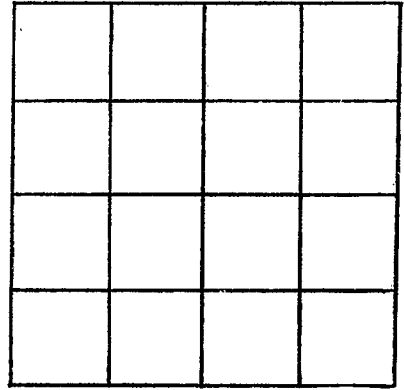

SECTION \_\_\_\_\_

Please indicate well location X.

ADDITIONAL INFORMATION

If more than one screen,  
show locations of each on sketch.