

Bureau of Land and Water Resource

Southport Mall

P.O. Box 10631

Jackson, Mississippi 39209

WATER WELL DRILLERS LOG

WILKINSON
B43

CODED.

6-18-1987
date well completed

RAYBORN DRILLING, INC.
firm name

Wilkinson
county well located

LANDOWNER: David New Drig

PO Box 1487

Natchez MS 39120
(mailing address)

WELL LOCATION:

sec. 45 T. 4 N R. 2 E
6 miles SE of Doloroso
(distance) (direction) (nearest town)

WELL PURPOSE: oilfield
(home, irrigation, municipal, industrial)

WELL COMPLETION DATA:

- (1) diameter (inches) 3"
- (2) total depth (feet) 410'
- (3) static water level (feet) 180' ^(below)/_(above) top of ground.
- (4) casing 3" 390'
(material) (depth)
- 3" If telescope see back.
(size)
- (5) screen 20' 390'
(length) (depth to top)
- 3" Slotted 31k Tyc
(size) (material)
- (6) pump - 60
(HP) (yield gpm)
- electric
(type power)
- (7) electric log no
(yes or no)
- (organization running log)
- (8) how well bottom plugged Wood

description of formations encountered

from to

Top Soil	0	3
Chalk	3	270
sand	270	336
Chalk	336	376
sand	376	410

Well Name:
Crosby Foster Creek Z # 2

RECEIVED

JUN 24 1987


Department of Natural Resources
Bureau of Land & Water Resources

DRILLERS REMARKS:

If well telescopes please sketch and show depths.

GROUND LEVEL

OH 211193 HCOYAR

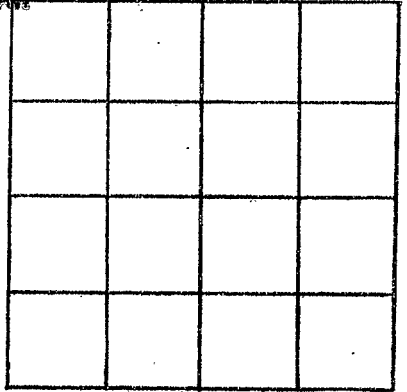

SECTION _____

Please indicate well location X.

ADDITIONAL INFORMATION

If more than one screen, show locations of each on sketch.