
	State Well F	Penort			
State Well Report		For Office Use Only:			
County: Wilkinson	Part 1		Aquifer:		
	Mississippi Department of Er	WITOIIIIIeintai Quainty	R-49		
Permit #:	Office of Land and Water Resources		Well #:		
Driller: Gary Rayborn	P.O. Box 10				
Driller:	Jackson, MS 392		L. S. Elevation:		
Date drilling completed:	(601)961-52		E-log #:		
	(601)354-6938 (fax) E-log #:				
State Law requires that this rep 30 days of completion of drilling	ort be prepared by the drille				
30 days of completion of drining Well Owner Informa	ation	Wel	1 Location		
		nday °'	_" Longitude:°'"		
Owner Name Solitude Pr					
Mailing Address: <u>90 A1 Day</u>	Vis Met	nod of Lat/Long (circle o	ne): Conventional Survey,		
4708 Hw	v I	USGS quad, Hand-held	d GPS, Survey-grade GPS		
Bacaland	A 70394	1/4 1/4 Sec 2	<u>O_Twn_4N_Rng_2W</u>		
Kaceland, L	ate Zip Code				
	050 Dist	ance Direction	of Dolarosso		
Telephone No. (985 537 - 7	0502	Villes			
	Well Data				
\sim			Othern		
Purpose of Well (circle on Home In		gation Fish Culture	Other:		
Date well drilling started:	60	r III'r a gwynlatadu	1125108		
Date well drilling started:	Date well of	Irilling completed:	100100		
		, ha)			
If flowing, method of flow regulation: V	alve Other (descri		MARINA		
210	· · · · · · · · · · · · · · · · · · ·	surface Date measured	1125108		
Static Water Level: <u>240</u> feet	above or below (Circle one) land a	Buto mouster			
	steel tape electric tape	air line other:			
Hole depth: <u>360</u> Well of		Vell grouted to a depth of	ffeet		
	F				
Type of grout (circle one): Cement) Bentonite Mix		DVC		
Casing length: <u>340</u> feet Ca	ing diameter:in	ches Type of casing:	FVC		
			3(-0		
Screen slot size: • OIO inche	s Setting depth: From <u>3</u> .	40feet to	<u>S60</u> feet		
Type of completion (circle all applicable			en hole Natural Development		
	Other (describe):				
Top of lap pipe or reduction in casing: _					
Top of lap pipe or reduction in casing:			Other		
Logs run (circle all applicable): No log					
Name of organization running log(s):	structed, and completed in acco	ordance with all applical	ble requirements of the Mississippi		
I certify that the well was drilled, con	I al Bring the Bring to the Dana	 ment of Health regulati	ons and state laws.		
Department of Environmental Qualit	y and/or the Mississippi Depart	ment of fleater regulati			
	Tag O-bo	ア			
Kayborn Drilling,			Children Hall Contractor		
Print Name of Water Well Contractor	and License No.	Signatur	e of Water Well Contractor		

AUE 9 8 2008 BY: OLWR If well telescopes please sketch below and show depths.



Description of Formations Encountered	From	To
 CHALK	0	85
FINE SAND	85	140
WHITE CHALK	140	155
Limestone and clay Bracks	155	275
Fine Sand	275	320
MEDIUM SAND	320	360
		1

If more than one screen, show location of each on sketch

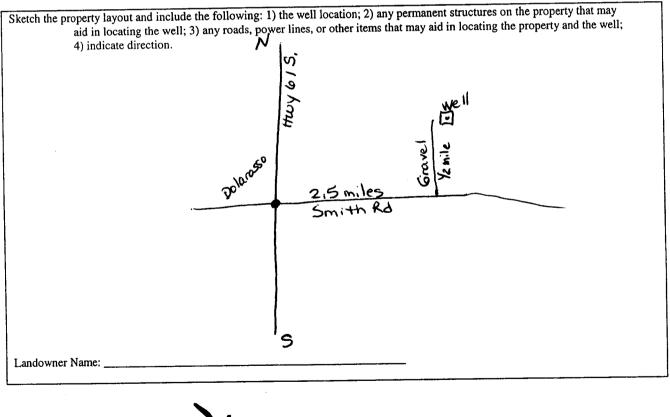

Signature of Water Well Contractor

AUG 9.8 2008 BY: OLWR

3- 48

STATE WI	ELL REPORT
County: Wilkinson Pump Installer' Permit #: Office of Land Driller: Gary Rayborn T125108 (601	For Office Use Only: s Completion Report nt of Environmental Quality and Water Resources Box 10631 MS 39289-0631)961-5210 54-6938 (fax) il and filed with the Department within 30 days of the
installation of pump. Well Owner Information	Well Location
Owner Name: Solitude Properties Mailing Address: <u>40 Al Davis</u> <u>4708 Huy I</u> <u>Raceland, LA 70394</u> City State Zip Code	Latitude:Longitude: Method of Lat/Long (circle one): Conventional Survey, USGS quad, Hand-held GPS, Survey-grade GPS 1414 Sec_20Twn_4N_Rng_2W Distance Direction Nearest Town 2.5_Miles East of Dokrosso
Pump Type Circle one	Power Type Circle one
Air LiftJetSubmersibleBucketPistonTurbine	Diesel EngineGasoline EngineNatural GasElectric MotorHandTractor PTO
Centrifugal Rotary Flowing Well Other (specify):	Windmill Other (specify): Horse Power Rating of Motor: 1 HP Setting Depth: 300 ' feet Number of Stages: 1 4
Pump Test Data Date Well Tested: 7-25-08 Static Water Level (A): 240 Feet Below Land Surface Pumping Water Level (B): Feet Below Land Surface Drawdown [(B) – (A)]: Feet Below Land Surface Test Pumping Rate: 10 Gallons Per Minute Duration of Pump Test (minimum 4 hours): hours	Method of Measuring Water Level Circle one Air Line Electric Measuring Line Steel Tape Other (specify):
I HEREBY CERTIFY that the above statements are true to the bes <u>Cary Rayborn</u> 0-60 Print Name of Pump Installer and License No. (if applicable)	t of my knowledge.

AUG 0 8 2008 BY: OLWR