

State Well Report

Part 1 - Driller's Log

Mississippi Department of Environmental Quality
Office of Land and Water Resources
P.O. Box 2309
Jackson, MS 39225
(601)961- 5210
(601)961- 5228 (fax)

County: Wilkinson
Permit #: 0-586
Driller: JAMES WELLS
Date drilling completed: 4-20-10

For Office Use Only:
Aquifer: B 54
Well #: _____
L. S. Elevation: _____
E-log #: _____

State Law requires that this report be prepared by the license holder responsible for the work and filed with the Department at the above address within 30 days of completion of drilling of the well or borehole.

Information on Well Owner <i>(Landowner if borehole is not for a water well)</i>	Well or Borehole Location
Owner Name: <u>Tony Cashiola</u>	Latitude: <u>31° 16' 44"</u> Longitude: <u>91° 17' 17"</u>
Mailing Address: <u>5140 Gench Rd.</u>	Method of Lat/Long (circle one): Conventional Survey,
<u>Port Allen LA 70767</u>	USGS quad, Hand-held GPS, Survey-grade GPS
City State Zip Code	<u>SW 1/4 SE 1/4 Sec 33 Twn 4N Rng 2W</u>
Telephone No. <u>(225) 344-8669</u>	Distance Direction Nearest Town <u>17</u> Miles <u>N</u> of <u>Woodville</u>

Well / Borehole Data

Date drilling started: 4-20-10 Date drilling completed: 4-20-10 Hole depth: 320 Hole diameter: 7 1/2"

Location of the source of any surface water used for drilling: running creek
Method of dosing and volume of Chlorine used in drilling and development: shock

Logs run (circle all applicable): No log run Electric Gamma Ray Density Sonic Neutron Other: _____
Name of organization running log(s): _____

Purpose of borehole (check one): Water Well Geotechnical/Geological Investigation _____ Ground Source Heat Pump _____
Seismic Survey _____ Other (describe) _____
If drilling is not related to water well construction, skip the remainder of this block

Purpose of Well (check one): Home Industrial _____ Public Supply _____ Irrigation _____ Fish Culture _____ Other: _____

If a flowing well, method of flow regulation: Valve _____ Other (describe) _____

Static Water Level: 200 feet above or below (circle one) land surface Date measured: 4-20-10

Method of Measurement (circle one) steel tape electric tape air line other: _____

Well depth: 320 Well grouted to a depth of 10 feet Type of grout (circle one): Neat Cement Bentonite Mix

Casing length: 300 feet Casing diameter: 4 inches Type of casing: PVC

Screen length: 20 feet Screen diameter: 4 inches Type of screen: PVC

Screen slot size: .008 inches Setting depth: From 300 feet to 320 feet

Type of completion (circle all applicable): Gravel packed Underreamed Telescoped Open hole Natural Development
Other (describe): _____

Top of lap pipe or reduction in casing: _____ feet. *If telescoped or more than one screen, describe on next page*


Form: OLWR-SWR-1A (04/08)

RECEIVED
MAY 13 2010
BY: OLWR

B 54

The sketch below only required for water wells


If well telescopes, show depths on sketch.

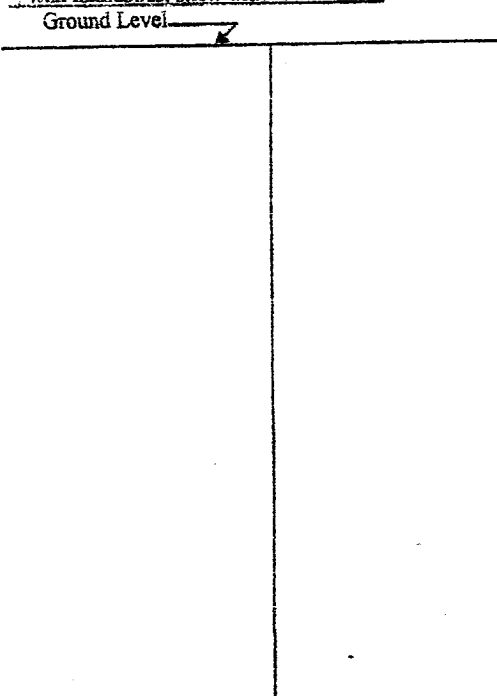

Description of formations encountered must be provided for all wells and boreholes, unless specifically exempted by regulations

Description of Formations Encountered	From (depth)	To (depth)
topsoil	Ground Level	L
clay	1	70
rock	70	75
clay	75	260
sand	260	320

If more than one screen, show location of each on sketch

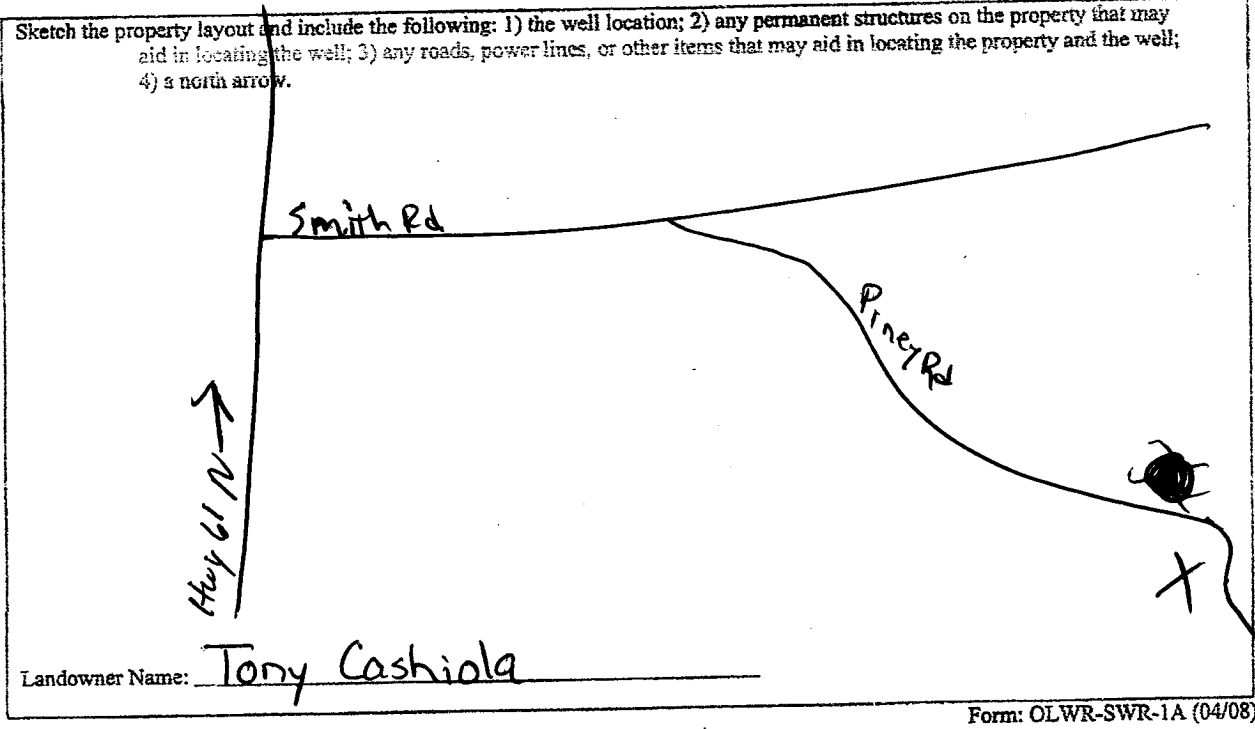

Form: OLWR-SWR-1A (04/08)

I certify that the well/borehole was drilled, constructed, and completed in accordance with all applicable requirements of the Mississippi Department of Environmental Quality and the Mississippi Department of Health regulations, if applicable, and state laws.

Print Name of Responsible Licensee and License No. JAMES WELLS 0-586 _____ Date _____

Signature of Licensee James Wells **RECEIVED**

MAY 13 2010
BY: OLWR

STATE WELL REPORT

Part 2

Pump Installer's Completion Report
 Mississippi Department of Environmental Quality
 Office of Land and Water Resources
 P.O. Box 2309
 Jackson, MS 39225
 (601)961-5210
 (601)961-5228 (fax)

County: _____
 Permit #: _____
 Driller: JAMES WELLS
 Date completed: 4-20-10
Copy information from block on Part 1

For Office Use Only:

Aquifer: BS4
 Well #: _____
 Elevation: _____

This part of the report must be completed by a licensed water well contractor or a licensed pump installer. A copy of Part 1 of the report must be attached and both parts filed with the Department at the above address within 30 days of well completion.

Well Owner Information	Well Location
Owner Name: <u>Tony Cashiola</u>	Latitude: _____ Longitude: _____
Mailing Address: <u>5140 Geach Rd.</u>	Method of Lat/Long (check one): Conventional Survey _____
<u>Port Allen LA 70767</u>	USGS quad _____, Hand-held GPS _____, Survey-grade GPS _____
City State Zip Code	_____ 1/4 _____ 1/4 Sec. <u>33</u> T <u>4N</u> R <u>2W</u>
Telephone No. <u>(225) 344-8669</u>	Distance Direction Nearest Town
	<u>17</u> Miles <u>N</u> of <u>Woodville</u>

Pump Type Circle one	Power Type Circle one
Air Lift Jet <input checked="" type="radio"/> Submersible	Diesel Engine Gasoline Engine Natural Gas
Bucket Piston Turbine	<input checked="" type="radio"/> Electric Motor Hand Tractor PTO
Centrifugal Rotary Flowing Well	Windmill Other (specify): _____
Other (specify): _____	Horse Power Rating of Motor: <u>1</u>
Date Pump Installed: <u>4-20-10</u>	Setting Depth: <u>250</u> feet
Rated Pump Capacity: <u>12</u> Gallons Per Minute	Number of Stages: <u>14</u>

Pump Test Data	Method of Measuring Water Level Circle one
Date Well Tested: <u>4-20-10</u>	Air Line Electric Measuring Line <input checked="" type="radio"/> Steel Tape
Static Water Level (A): <u>200</u> Feet Below Land Surface	Other (specify): _____
Pumping Water Level (B): <u>250</u> Feet Below Land Surface	For flowing well, measured shut in head: _____ feet
Drawdown [(B) - (A)]: <u>210</u> Feet Below Land Surface	Well yielded <u>17</u> GPM with a drawdown of
Test Pumping Rate: <u>17</u> Gallons Per Minute	<u>10</u> feet after <u>4</u> hours of pumping
Duration of Pump Test (minimum 4 hours): <u>4</u> hours	

I HEREBY CERTIFY that the above statements are true to the best of my knowledge.

JAMES WELLS 0-586 James Wells
 Print Name of Pump Installer and License No. (if applicable) Signature of Pump Installer

RECEIVED
 Form: OLWR-SWR-11
MAY 13 2010
BY: OLWR