

WILKINSON
 B 2000
 12/6/77

MISSISSIPPI
 BOARD OF WATER COMMISSIONERS
 416 North State Street
 Jackson, Mississippi 39201

WATER WELL DRILLERS LOG

Wilkinson

12-6 1977 *Raytheon Drill & Const. Co.* *Jep*
 date well completed firm name county well located


LANDOWNER:	description of formations encountered	from	to
<i>Paul Knight</i>	<i>Top soil</i>	<i>0</i>	<i>2</i>
(mailing address)	<i>Red clay</i>	<i>2</i>	<i>10</i>
WELL LOCATION: sec. <i>28</i> T. <i>4</i> N. R. <i>2</i> E. S. <i>2 1/2</i> miles <i>SE</i> of <i>Dalozess</i> (distance) (direction) (nearest town)	<i>grey clay</i>	<i>10</i>	<i>20</i>
WELL PURPOSE: <i>Home</i> (home, irrigation, municipal, industrial)	<i>fine sand</i>	<i>20</i>	<i>25</i>
WELL COMPLETION DATA: (1) diameter (inches) <i>2"</i> (2) total depth (feet) <i>230'</i> (3) static water level (feet) <i>126'</i> below/above top of ground. (4) casing <i>galv.</i> <i>213'</i> (material) (depth) <i>2"</i> if telescope see back. (size) (5) screen <i>5'</i> <i>213'</i> (length) (depth to top) <i>2"</i> <i>155"</i> (size) (material) (6) pump <i>2</i> <i>6 Gpm</i> (HP) (yield gpm) <i>elec.</i> (type power) (7) electric log <i>no</i> (yes or no) (organization running log) (8) how well bottom plugged <i>wood plug</i>	<i>blue clay</i>	<i>25</i>	<i>168</i>
	<i>Coarse sand</i>	<i>168</i>	<i>220</i>
DRILLERS REMARKS:			

RECEIVED
 APR 20 1978

MISS. BD. OF WATER COMMISSIONERS

If well telescopes please sketch and show depths.

GROUND LEVEL

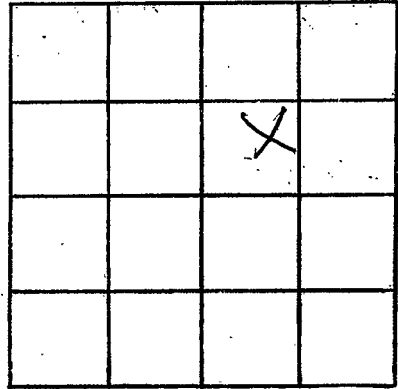

SECTION 28

Please indicate well location X.

ADDITIONAL INFORMATION

If more than one screen, show locations of each on sketch.