

WILKINSON
 B 2001
 02-16-79

MISSISSIPPI
 BOARD OF WATER COMMISSIONERS
 416 North State Street
 Jackson, Mississippi 39201

WATER WELL DRILLERS LOG

2-16 1979 Rayborn Drill. & Const Co. Wilkinson
 date well completed firm name county well located

LANDOWNER: Ernie Davis

description of formations encountered	from	to
<u>Top soil</u>	<u>0</u>	<u>2</u>
<u>blue clay</u>	<u>2</u>	<u>36</u>
<u>sand</u>	<u>36</u>	<u>90</u>

(mailing address)
 WELL LOCATION:
 sec. 22 T-4 N R-2 E
N miles 1 1/2 of Dalton
 (distance) (direction) (nearest town)

WELL PURPOSE: Home
 (home, irrigation, municipal, industrial)

WELL COMPLETION DATA:

(1) diameter (inches) 4"

(2) total depth (feet) 90'

(3) static water level (feet) 22' below top of ground. above

(4) casing PVC, 90'
 (material) (depth)
4" if telescope see back.
 (size)

(5) screen 10', 90'
 (length) (depth to top)
4", PVC
 (size) (material)

(6) pump 1/2,
 (HP) (yield gpm)
ele.
 (type power)

(7) electric log no
 (yes or no)

(organization running log)

(8) how well bottom plugged wood plug

Miss. Board of Water Comm.


APR 16 1979

RECEIVED

DRILLERS REMARKS:

If well telescopes please sketch and show depths.

GROUND LEVEL

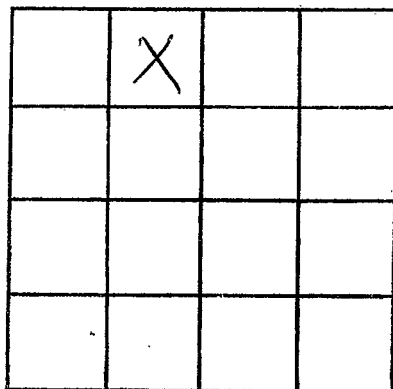

SECTION 32

Please indicate well location X.

ADDITIONAL INFORMATION

If more than one screen,
show locations of each on sketch.