

W.S. Kirkson
B3000
9-13-79

MISSISSIPPI
 BOARD OF WATER COMMISSIONERS
 416 North State Street
 Jackson, Mississippi 39201

WATER WELL DRILLERS LOG

9-13 1979 date well completed
 Rayborn Drilling & Const. Co. firm name
 Wilkinson county well located

LANDOWNER:

Robert Johnson
Rt 1 Box 1215
Woodville, MS.
 (mailing address)

description of formations encountered

from to

<u>top soil</u>	<u>0</u>	<u>2</u>
<u>bluish clay</u>	<u>2</u>	<u>100</u>
<u>fine sand</u>	<u>100</u>	<u>125</u>
<u>grey clay</u>	<u>125</u>	<u>190</u>
<u>coarse sand</u>	<u>190</u>	<u>225</u>

WELL LOCATION:

sec. 34 T 4 N R 2 E
4 miles SE of Belrose
 (distance) (direction) (nearest town)

WELL PURPOSE: home
 (home, irrigation, municipal, industrial)

WELL COMPLETION DATA:

- (1) diameter (inches) 2"
- (2) total depth (feet) 225'
- (3) static water level (feet) 180' ^{below} _{above} top of ground.
- (4) casing galv. 218'
 (material) (depth)
2"
 (size) if telescope see back.
- (5) screen 5' 218'
 (length) (depth to top)
2" 1155"
 (size) (material)
- (6) pump 1 1/2 Hp. 6 Gpm
 (HP) (yield gpm)
elec.
 (type power)
- (7) electric log no
 (yes or no)
 (organization running log)
- (8) how well bottom plugged wood plug

DRILLERS REMARKS:


DEPT. OF NATURAL RESOURCES
 BUREAU OF LAND & WATER RESOURCES

DEC 20 1979

RECEIVED

If well telescopes please sketch and show depths.

GROUND LEVEL

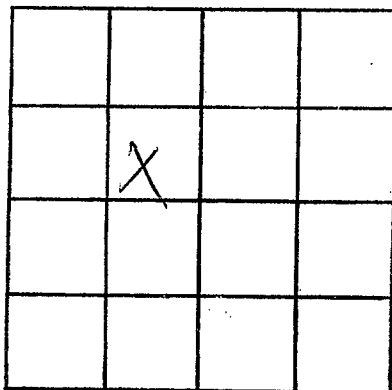

SECTION 34

Please indicate well location X.

ADDITIONAL INFORMATION

If more than one screen,
show locations of each on sketch.