

MISSISSIPPI DEPARTMENT OF NATURAL RESOURCES

Bureau of Land and Water Resources

Southport Mall

P.O. Box 10631

Jackson, Mississippi 39209

WATER WELL DRILLERS LOG

Wilkinson  
B 2003

5-19 1982 Rayborn Drill. & Concr. Wilkinson  
date well completed firm name county well located

LANDOWNER:	description of formations encountered	from	to
B. H. Fortenberry	Sand	0	200
Natchez, ms. (mailing address)	Chalk	200	330
WELL LOCATION:	Sand	330	360
sec. 5 T 4 S R 2 E			
(distance) miles (direction) of (nearest town)			
WELL PURPOSE: (home, irrigation, municipal, industrial)			
WELL COMPLETION DATA:			
(1) diameter (inches) 3"			
(2) total depth (feet) 360			
(3) static water level (feet) 100' below top of ground.			
(4) casing (material) Blk (depth) 360'			
3" (size) if telescope see back.			
(5) screen (length) 20' (depth to top) 340'	Armstrong ST		
3" (size) slotted Pipe (material)			
(6) pump (HP) 1 (yield gpm) 52 Gpm			
(type power)			
(7) electric log (yes or no) No			
(organization running log)			
(8) how well bottom plugged wood plug			
DRILLERS REMARKS:			


DEPT. OF NATURAL RESOURCES  
BUREAU OF LAND & WATER RESOURCES

MAY 21 1982

RECEIVED

If well telescopes please  
sketch and show depths.

GROUND LEVEL

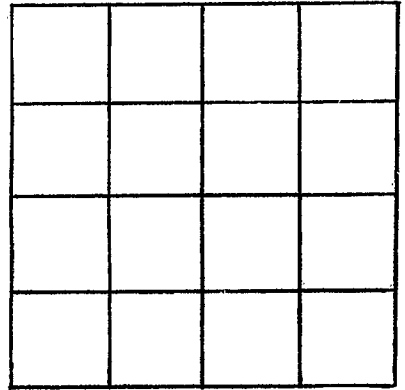

SECTION \_\_\_\_\_

Please indicate well location X.

ADDITIONAL INFORMATION

If more than one screen,  
show locations of each on sketch.