

WILKINSON
Bacon

MISSISSIPPI DEPARTMENT OF NATURAL RESOURCES
Bureau of Land and Water Resources
Southport Mall
P.O. Box 10631
Jackson, Mississippi 39209
WATER WELL DRILLERS LOG

CODED

4/17 1986 Rayborn Drilling Co. Wilkinson
date well completed firm name county well located

LANDOWNER:	description of formations encountered	from	to
D & D Drilling Co. P.O. Box 351 Ferriday LA 71334 (mailing address)	Chalk	0	170
WELL LOCATION: sec. 25 T. 4 N. R. 2 E 1 miles S of Doloroso (distance) (direction) (nearest town)	Sand	170	185
WELL PURPOSE: oilfield (home, irrigation, municipal, industrial)	Chalk	185	290
WELL COMPLETION DATA: (1) diameter (inches) 3" (2) total depth (feet) 441' (3) static water level (feet) 130' (below) above top of ground. (4) casing BKT+C, 421' (material) (depth) 3" (size) If telescope see back. (5) screen 20' (length), 421' (depth to top) 3" (size), BKT+C Slotted pipe (material) (6) pump 50 (yield gpm) electric (type power) (7) electric log no (yes or no) (organization running log) (8) how well bottom plugged wood	Sand	290	330
	Rot/sand	330	400
	Sand	400	441
DRILLERS REMARKS:			


CODED

RECEIVED
SEP 19 1986

Department of Natural Resources
Bureau of Land & Water Resources

If well telescopes please sketch and show depths.

GROUND LEVEL

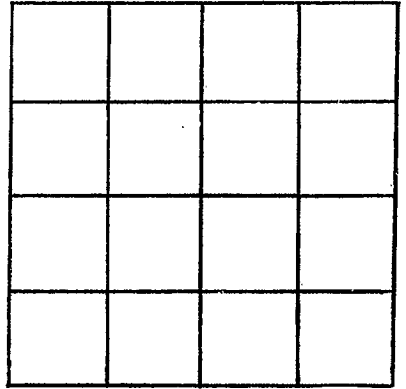

SECTION _____

Please indicate well location X.

ADDITIONAL INFORMATION

If more than one screen,
show locations of each on sketch.