

MISSISSIPPI DEPARTMENT OF ENVIRONMENTAL QUALITY

Office of Land and Water Resources

P. O. Box 10631
Jackson, MS 39289-0631
WATER WELL DRILLERS LOG

COUNTY WELL LOCATED <i>Wilkinson</i>
WELL NUMBER CODED <i>B 2009</i>
DATE WELL COMPLETED <i>5-23-98</i>

PERMIT NUMBER <i>0-287</i>
NAME OF DRILLING FIRM <i>Reeves Well Ser.</i>

NAME & MAILING ADDRESS OF LANDOWNER <i>Robert Jones</i>		
WELL LOCATION: SEC <i>35</i> TOWNSHIP <i>4</i> RANGE <i>2</i>		
DISTANCE <i>12</i> Miles	DIRECTION <i>N</i>	NEAREST TOWN <i>WOODVILLE</i>
OTHER LANDMARK		
WELL PURPOSE: <u>Home</u> , Irrigation, Municipal, Industrial, Fish Pond, etc.		

PUMP DATA		
PUMP TYPE (Circle One): Submersible, Turbine, Jet, Flowing Well, Other (Describe)		
POWER TYPE (Circle One): Electric, Tractor, Diesel, Gasoline, Butane, Other (Describe) <i>1</i> H/P		
Pump Capacity (GPM) <i>10</i>	No. of Stages <i>14</i>	Setting Depth <i>220</i> FT.
PUMP TEST Well yielded <i>50</i> GPM with a drawdown of <i>20</i> ft. after <i>1</i> hours of pumping		

WELL DATA		
Well Depth <i>250'</i>	Casing Diameter (In.) <i>4"</i>	Casing Length (Ft.) <i>20'</i>
Type of Casing <i>PVC</i>	Hole Depth <i>250'</i>	Depth to Static Water Level <i>160'</i>
TYPE OF COMPLETION: (Circle One or More): Gravel Packed, Underreamed, Telescoped, Natural Development, Open Hole, Other (Describe) <i>10 Gal. sand</i>		
WELL GROUTED TO A DEPTH OF <i>10</i> FEET Type Grout (circle one): <u>Cement</u> , Bentonite, or Mix		

LOG DATA	
TYPE OF LOG RUN (Circle One): Electric, Gamma Ray, Density, Sonic, Neutron, Other (Describe) <u>No Log Run</u>	
Name of Organization Running Log	

SCREEN DATA		
Diameter - inches <i>4"</i>	Length - Feet <i>10'</i>	Slot Size - Inches <i>10 THDS.</i>
Screen Type <i>PVC</i>	Depth to Bottom - Feet <i>250'</i>	


GEOLOGIC DATA (Office Use Only)			
Surface Elev.	Geologic Unit	Unit Thickness	Depth to Top
Subs. SWL	Date	Analysis	Aquifer Test
Driller's Remarks			
Top of Lap Pipe or Reduction in Casing			
FEET IF TELESCOPED OR MORE THAN ONE SCREEN: USE BACK PAGE			

DESCRIPTION OF FORMATIONS ENCOUNTERED	FROM	TO
<i>clay</i>	<i>0</i>	<i>25</i>
<i>sand</i>	<i>25</i>	<i>70</i>
<i>chalk</i>	<i>70</i>	<i>140</i>
<i>cherty sand</i>	<i>140</i>	<i>180</i>
<i>blue chalk</i>	<i>180</i>	<i>230</i>
<i>coarse sand</i>	<i>230</i>	<i>250</i>

FORMATIONS (Continued)	FROM	TO
RECEIVED		
JUN 28 1999		
Dept of Environmental Quality Office of Land & Water Resources		
IF MORE SPACE IS NEEDED, USE BACK		

If well telescopes please sketch and show depths.

GROUND LEVEL

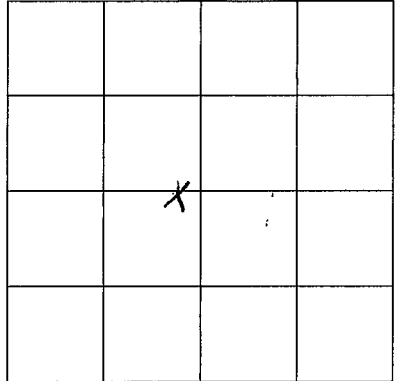


SECTION 35

Please indicate well location X.

ADDITIONAL INFORMATION

Multiple horizontal lines for additional information.

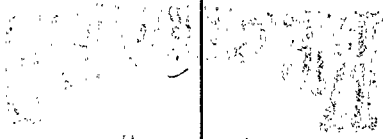

If more than one screen, show location of each on sketch.