

MISSISSIPPI DEPARTMENT OF ENVIRONMENTAL QUALITY

Office of Land and Water Resources

P. O. Box 10631  
Jackson, MS 39289-0631  
WATER WELL DRILLERS LOG

COUNTY WELL LOCATED  
Waltham  
WELL NUMBER B-2010 CODED  
DATE WELL COMPLETED  
7-15-01

PERMIT NUMBER 079  
NAME OF DRILLING FIRM  
Reeves Well Ser.

NAME & MAILING ADDRESS OF LANDOWNER  
Elsa L. Moran  
Logansport  
Latitude:  
Longitude:  
WELL LOCATION. SEC 32 TOWNSHIP 4<sup>N</sup> RANGE 2<sup>E</sup>  
DISTANCE 10 Miles DIRECTION NNE of NEAREST TOWN Woodville  
OTHER LANDMARK  
WELL PURPOSE: Home, Irrigation, Municipal, Industrial, Fish Pond, etc.

PUMP DATA  
PUMP TYPE (Circle One):  
Submersible, Turbine, Jet, Flowing Well, Other (Describe) \_\_\_\_\_  
POWER TYPE (Circle One):  
Electric, Tractor, Diesel, Gasoline, Butane, Other (Describe) \_\_\_\_\_ H/P 1  
DESCRIPTION OF FORMATIONS ENCOUNTERED FROM TO  
Clay 0 20  
red sand 20 80  
Chalk 80 120  
loamy sand 120 170  
concrete sand 170 190  
RECEIVED  
FEB 27 2002  
BY: OLWR  
Top of Lap Pipe or Reduction in Casing  
FEET IF TELESCOPED OR MORE THAN ONE SCREEN: USE BACK PAGE

WELL DATA

Well Depth 190' Casing Diameter (In.) 4" Casing Length (Ft.) 20'  
Type of Casing PVC Hole Depth 190' Depth to Static Water Level 120'  
TYPE OF COMPLETION: (Circle One or More):  
Gravel Packed, Underreamed, Telescoped,  
Natural Development, Open Hole, Other  
(Describe) 10' of sand  
WELL GROUTED TO A DEPTH OF 10' FEET  
Type Grout (circle one): Cement, Bentonite, or Mix

SCREEN DATA

Diameter - Inches 4" Length - Feet 10' Slot Size - Inches 10 Mesh  
Screen Type PVC Depth to Bottom - Feet 190'

I certify that the well was drilled, constructed and completed in accordance with all applicable Requirements of the Mississippi Department of Environmental Quality and/or the Mississippi Department of Health regulations and state laws.


Jimmy Reeves 0-668  
Signature of Licensed Driller and License No.

2-13-02  
Date

Additional Information Required On Back

If well telescopes please sketch and show depths.

GROUND LEVEL

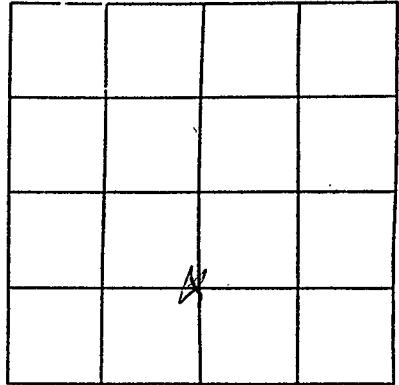

SECTION 32

Please indicate well location X.

|                     |               |                |
|---------------------|---------------|----------------|
| Pump Capacity (GPM) | No. of Stages | Setting Depth  |
| <u>10</u>           | <u>12</u>     | <u>160</u> FT. |

PUMP TEST

Well yielded 50 GPM with  
a drawdown of 0 ft.  
after 1 hours of pumping

LOG DATA

TYPE OF LOG RUN (Circle One): No Log Run,  
Electric, Gamma Ray, Density, Sonic, Neutron,  
Other (Describe) \_\_\_\_\_

Name of Organization Running Log \_\_\_\_\_

GEOLOGIC DATA (Office Use Only)

| Surface Elev. | Geologic Unit | Unit Thickness | Depth to Top |
|---------------|---------------|----------------|--------------|
| Subs. SWL     | Date          | Analysis       | Aquifer Test |

Driller's Remarks

\_\_\_\_\_  
\_\_\_\_\_  
If more than one screen,  
show location of each on sketch.