

Wilkinson  
 C2  
 6-68

MISSISSIPPI  
 BOARD OF WATER COMMISSIONERS  
 416 North State Street  
 Jackson, Mississippi 39201

CODE 1

WATER WELL DRILLERS LOG

Central Cont. Co.  
 firm name

Wilkinson  
 county well located

6-17-68 19  
 date well completed

LANDOWNER: DARRINGTON #1

description of formations encountered

from to

SHALE 0 18'  
 SAND & GRAVEL 18 185'

NATCHEZ DRILLING CO  
 (mailing address)


WELL LOCATION:

sec. 9 T 4 N R 1  
 12 miles W of ROSETTA  
 (distance) (direction) (nearest town)

WELL PURPOSE: Supply  
 (home, irrigation, municipal, industrial)

WELL COMPLETION DATA:


- (1) diameter (inches) 3"
- (2) total depth (feet) 185'
- (3) static water level (feet) 40' below top of ground.
- (4) casing steel, 168'  
 (material) (depth)  
 (size) if telescope see back.
- (5) screen 17', 168'  
 (length) (depth to top)  
 3", SLOTTED PIPE  
 (size) (material)
- (6) pump AIR  
 (HP) (yield gpm)  
 Butane  
 (type power)
- (7) electric log NO  
 (yes or no)  
 (organization running log)
- (8) how well bottom plugged  
 RIDDEN CLAY

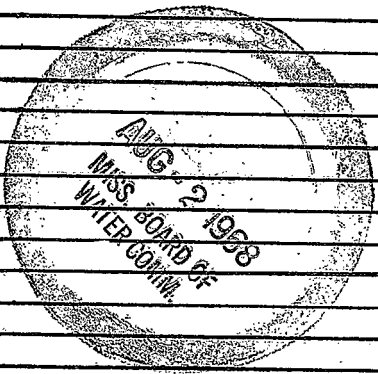

DRILLERS REMARKS:

If well telescopes please sketch and show depths.

GROUND LEVEL

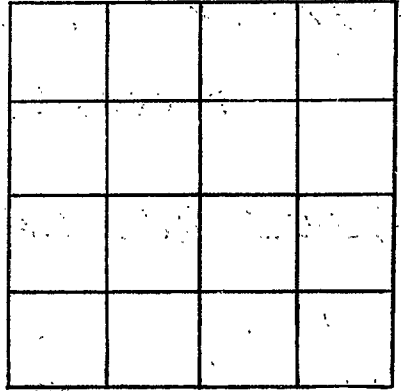

SECTION \_\_\_\_\_

Please indicate well location X.

ADDITIONAL INFORMATION

If more than one screen, show locations of each on sketch.