

WILKINSON
C.3
6-16-72

MISSISSIPPI
BOARD OF WATER COMMISSIONERS
416 North State Street
Jackson, Mississippi 39201

WATER WELL DRILLERS LOG

June 16 1972 Chester Kellogg Wilkerson
date well completed firm name county well located

LANDOWNER: Kerman Ashley
Rt 1, Crasby
(mailing address)

WELL LOCATION:
sec. 14 T. 4 R. 1
7 miles WNW of Osella
(distance) (direction) (nearest town)

WELL PURPOSE: same
(home, irrigation, municipal, industrial)

WELL COMPLETION DATA:


- (1) diameter (inches) 4"
- (2) total depth (feet) 117
- (3) static water level (feet) 68 below above top of ground.
- (4) casing Plast bottom
(material) (depth)
- (size) If telescope see back.
- (5) screen 6' 117
(length) (depth to top)
- 4" Plast
(size) (material)
- (6) pump 1/2 HP 12
(HP) (yield gpm)
- Elect
(type power)
- (7) electric log No.
(yes or no)

(organization running log)

(8) how well bottom plugged wood plug

DRILLERS REMARKS: old well back

description of formations encountered	from	to
Clay	0	16
Sand & gravel	16	28
Blue chalk	28	40
Sand & gravel	40	55
White chalk	55	92
Coarse sand	92	117

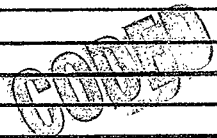


NOV 28 1972

MISSISSIPPI
BOARD OF WATER COMMISSIONERS

If well telescopes please sketch and show depths.

GROUND LEVEL

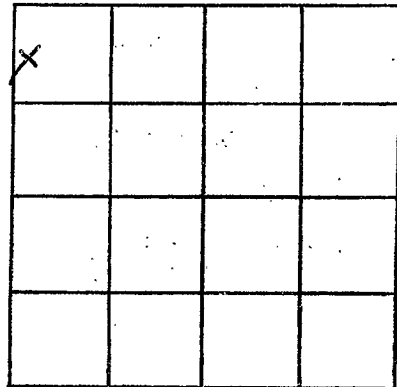

SECTION 14

Please indicate well location X.

ADDITIONAL INFORMATION

If more than one screen, show locations of each on sketch.