

Wilkinson  
C 4  
12-68

MISSISSIPPI  
BOARD OF WATER COMMISSIONERS  
416 North State Street  
Jackson, Mississippi 39201

INDEXED  
FILED

WATER WELL DRILLERS LOG

Dec 17 1968 Reineswell Pump Co. Wilkinson  
date well completed firm name county well located

LANDOWNER: Walter  
Collin  
Rt-1, Crasby -  
(mailing address)

description of formations encountered	from	to
Brown Clay	0	16
White Sand	16	97
Coarse white sand	97	108

WELL LOCATION:  
sec. 43 T. 4 N. R. 1 E  
7 miles NW of Crasby  
(distance) (direction) (nearest town)

WELL PURPOSE: Home  
(home, irrigation, municipal, industrial)

- WELL COMPLETION DATA:
- (1) diameter (inches) 4"
  - (2) total depth (feet) 108
  - (3) static water level (feet) 55 below top of ground.
  - (4) casing Plastic Ballons  
(material) (depth)  
(size) if telescope see back.
  - (5) screen 6' length, 102' depth to top  
4" (size) Plastic (material)
  - (6) pump 1/2 sub 1 1/2  
(HP) (yield gpm)  
elect. (type power)
  - (7) electric log NO  
(yes or no)  
(organization running log)

(8) how well bottom plugged  
wooden plug

DRILLERS REMARKS:  
old well bad.


INDEXED

MISS. SEA. OF WATER COMM. 27 1968

MISS. SEA. OF WATER COMM.

If well telescopes please sketch and show depths.

GROUND LEVEL

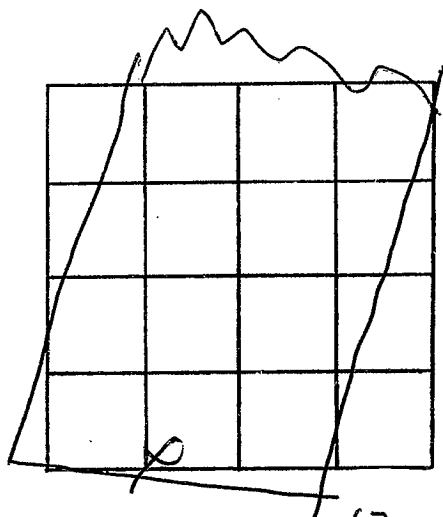

SECTION 43

Please indicate well location X.

ADDITIONAL INFORMATION

If more than one screen,  
show locations of each on sketch.