

Milkinson
 C5
 11-15-68

MISSISSIPPI
 BOARD OF WATER COMMISSIONERS
 416 North State Street
 Jackson, Mississippi 39201

CODED

WATER WELL DRILLERS LOG

11-15-68 date well completed
 Milkinson firm name
 Wilkerson county well located

LANDOWNER: Jal Roberts

description of formations encountered

from to

H-1, Coashy -
 (mailing address)

clay	9	8
white sand	9	30
fine sand	30	33
limestone shale	33	67
fine sand	67	72
coarse white sand	72	80

WELL LOCATION:

sec 24 T 4 N R 1 E
 (distance) miles (direction) of (nearest town)

WELL PURPOSE: farm
 (home, irrigation, municipal, industrial)

WELL COMPLETION DATA:

(1) diameter (inches) 4 1/2"
 (2) total depth (feet) 80
 (3) static water level (feet) 56 below top of ground

(4) casing Plastic
 (material) (depth)
 (size) If telescope see back.

(5) screen 6' 74'
 (length) (depth to top)
4" Plastic
 (size) (material)

(6) pump 6
 (HP) (yield gpm)
Elect
 (type power)

(7) electric log no
 (yes or no)
 (organization running log)

(8) how well bottom plugged
wooden plug

DRILLERS REMARKS:
red well log


CODED

DEC 13 1968

MISS. BD. OF
 WATER COMM.

If well telescopes please sketch and show depths.

GROUND LEVEL

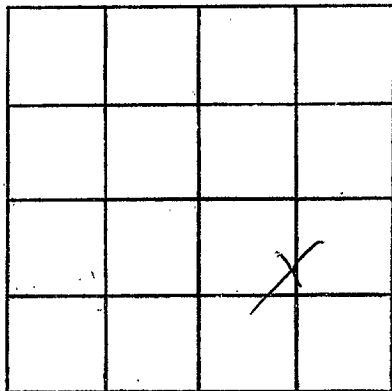

SECTION 22

Please indicate well location X.

ADDITIONAL INFORMATION

If more than one screen,
show locations of each on sketch.