

Wilkinson
 C 6
 2-13-70

MISSISSIPPI
 BOARD OF WATER COMMISSIONERS
 416 North State Street
 Jackson, Mississippi 39201

CODED

WATER WELL DRILLERS LOG

2-13 1970 Heiner water well, Inc. Wilkinson
 date well completed firm name county well located

LANDOWNER: William Phipps
Route #1, Crosby Miss.
 (mailing address)

description of formations encountered	from	to
<u>Top Soil</u>	<u>0</u>	<u>2</u>
<u>Shale</u>	<u>2</u>	<u>10</u>
<u>Sand & Gravel</u>	<u>10</u>	<u>147</u>

WELL LOCATION:
 sec. 9 T-4 N R-1 E
14 miles N of Woodville
 (distance) (direction) (nearest town)

WELL PURPOSE: Home
 (home, irrigation, municipal, industrial)

- WELL COMPLETION DATA:
- (1) diameter (inches) 2"
 - (2) total depth (feet) 147'
 - (3) static water level (feet) 40' below top of ground.
 - (4) casing Galv. 140'
 (material) (depth)
2" if telescope see back.
 (size)
 - (5) screen 5' 140'
 (length) (depth to top)
2" S.S.
 (size) (material)
 - (6) pump 1 5
 (HP) (yield gpm)
electric
 (type power)
 - (7) electric log no
 (yes or no)
- (organization running log)
- (8) how well bottom plugged wood plug

CODED


MAR 11 1970

DRILLERS REMARKS:

MISS. BD. OF
 WATER COMM.

If well telescopes please sketch and show depths.

GROUND LEVEL

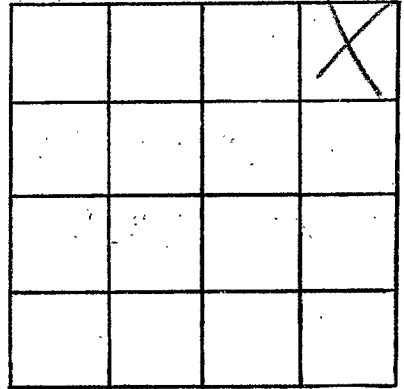

SECTION 9

Please indicate well location X.

ADDITIONAL INFORMATION

If more than one screen, show locations of each on sketch.