

WILKINSON
 C 8
 2-26-72

CODED MISSISSIPPI
 BOARD OF WATER COMMISSIONERS
 416 North State Street
 Jackson, Mississippi 39201

MAR 6 1972

WATER WELL DRILLERS LOG

2-26 1972 Griner Water Wellers Wilkinson
 date well completed firm name county well located

LANDOWNER:	description of formations encountered	from	to
J. O. Vines	Top soil	0	1
Crosby, Miss. (mailing address)	Chalk	1	10
	Sand & Gravel	10	130

WELL LOCATION:
 sec. 7 T 4 N R 1 E
7 miles NW of Oslova
 (distance) (direction) (nearest town)

WELL PURPOSE: Home
 (home, irrigation, municipal, industrial)


- WELL COMPLETION DATA:**
- (1) diameter (inches) 2"
 - (2) total depth (feet) 130'
 - (3) static water level (feet) 40' below top of ground.
 - (4) casing Galv. 123'
 (material) (depth)
2"
 (size) if telescope see back.
 - (5) screen 5' 123'
 (length) (depth to top)
2" 55
 (size) (material)
 - (6) pump 2 8 GPM
 (HP) (yield gpm)
elec.
 (type power)
 - (7) electric log no.
 (yes or no)
- (organization running log)
- (8) how well bottom plugged lined plug

CODED

DRILLERS REMARKS:

If well telescopes please sketch and show depths.

GROUND LEVEL

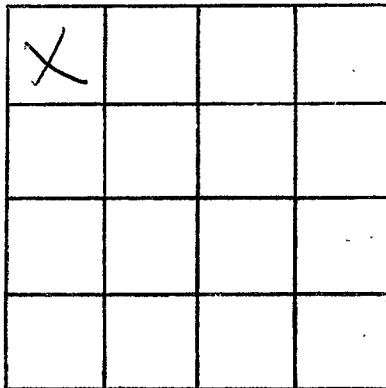

SECTION 7

Please indicate well location X.

ADDITIONAL INFORMATION

If more than one screen,
show locations of each on sketch.