

WILKINSON
C9
3-8-72

MISSISSIPPI
 BOARD OF WATER COMMISSIONERS
 416 North State Street
 Jackson, Mississippi 39201

CODED

WATER WELL DRILLERS LOG

3-8 1972 Haines Water Well Co. Wilkinson
 date well completed firm name county well located

LANDOWNER:	description of formations encountered	from	to
<u>D. V. Perry</u> Rt #1 <u>Crosby, Miss</u> (mailing address)			
	<u>Chalk</u>	<u>2</u>	<u>10</u>
	<u>Sand & Gravel</u>	<u>10</u>	<u>112</u>

WELL LOCATION:
 sec. 7 T 4 N R 1 E
S
12 miles east of Polk
 (distance) (direction) (nearest town)

WELL PURPOSE: Home
 (home, irrigation, municipal, industrial)

- WELL COMPLETION DATA:
- (1) diameter (inches) 2"
 - (2) total depth (feet) 112'
 - (3) static water level (feet) 40' below above top of ground.
 - (4) casing Galv. 105'
(material) (depth)
2" if telescope see back.
(size)
 - (5) screen 5' 105'
(length) (depth to top)
2" SS
(size) (material)
 - (6) pump 2 76 gpm
(HP) (yield gpm)
elec
(type power)
 - (7) electric log no
(yes or no)
 - (organization running log)
 - (8) how well bottom plugged Wood Plug

CODED


APR 21 1972

DRILLERS REMARKS:

MISS. BUREAU OF
 WATER COMMISSIONERS

If well telescopes please sketch and show depths.

GROUND LEVEL

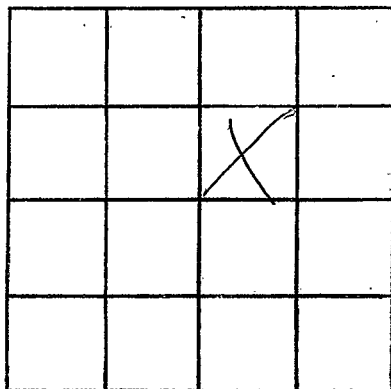

SECTION 7

Please indicate well location X.

ADDITIONAL INFORMATION

Lined area for additional information.

If more than one screen, show locations of each on sketch.