

Wilkinson  
C10  
6-1-73

MISSISSIPPI  
BOARD OF WATER COMMISSIONERS  
416 North State Street  
Jackson, Mississippi 39201

CODED

WATER WELL DRILLERS LOG

June 1, 1973 Chester Keener Wilkinson  
Date well completed firm name county well located

LANDOWNER: Thomas J. Keener  
Rt. 1, Coaling  
(mailing address)

WELL LOCATION:  
sec. 14 T. 4 N. R. 1 W. S. 20  
7 miles N Wilkinson  
(distance) (direction) (nearest town)

WELL PURPOSE: Domestic  
(home, irrigation, municipal, industrial)

WELL COMPLETION DATA:  
(1) diameter (inches) 4 1/2  
(2) total depth (feet) 82  
(3) static water level (feet) 44 below top of ground  
(4) casing Plast. Bottom  
(material) (depth)  
if telescope see back.  
(5) screen 6' 76'  
(length) (depth to top)  
4 1/2" Plast.  
(size) (material)  
(6) pump 1/2 HP 15  
(HP) (yield gpm)  
elect.  
(type power)  
(7) electric log NO  
(yes or no)  
(organization running log)

(8) how well bottom plugged  
wooden plug

DRILLERS REMARKS:  
New location


description of formations encountered	from	to
clay	0	12
white chalk	12	36
fine gravel & sand	36	42
fine white sand	42	68
coarse sand	68	82

CODED

RECEIVED  
MAY 24 1974

If well telescopes please sketch and show depths.

GROUND LEVEL

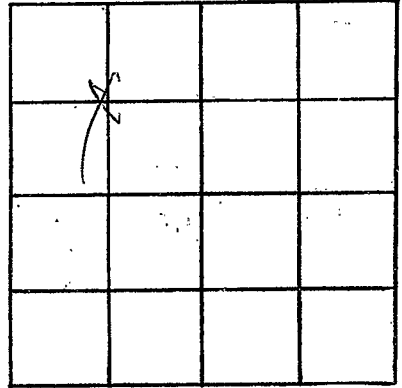

SECTION 14

Please indicate well location X.

ADDITIONAL INFORMATION

If more than one screen,  
show locations of each on sketch.