

WILKINSON
 C II
 8-3-73

MISSISSIPPI
 BOARD OF WATER COMMISSIONERS
 416 North State Street
 Jackson, Mississippi 39201

CODED

WATER WELL DRILLERS LOG

Aug 3 1973 date well completed
 Chester Keene firm name
 Wilkinson county well located

LANDOWNER: Jewell Underwood
 R.H. Crasby

(mailing address)

WELL LOCATION:

sec. 7 T 4 N R 1 E
 8 miles W of Waverly
 (distance) (direction) (nearest town)

WELL PURPOSE: farm
 (home, irrigation, municipal, industrial)

WELL COMPLETION DATA:

- (1) diameter (inches) 4"
- (2) total depth (feet) 148
- (3) static water level (feet) 65 below top of ground
- (4) casing Plast-Baltan (material) (depth)

if telescope see back.
 (size)

- (5) screen 6' (length) 142' (depth to top)

4" (size) Plast (material)

- (6) pump 1/2 HP (HP) 15 (yield gpm)

elect (type power)

- (7) electric log NO- (yes or no)

(organization running log)

- (8) how well bore plugged wood chips

description of formations encountered

from

to

clay	0	10
sand	10	20
chalk	20	40
sand	40	50
chalk	50	55
sand	55	148

CODED

DRILLERS REMARKS:


set well base

RECEIVED
 JUL 30 1973

MISS. BD. OF WATER COMMISSIONERS

If well telescopes please sketch and show depths.

GROUND LEVEL

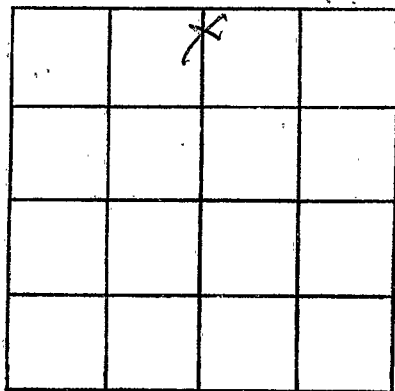

SECTION 7

Please indicate well location X.

ADDITIONAL INFORMATION

Lined area for additional information.

If more than one screen, show locations of each on sketch.