

WILKINSON  
 C 12  
 6-19-74

MISSISSIPPI  
 BOARD OF WATER COMMISSIONERS  
 416 North State Street  
 Jackson, Mississippi 39201

CODED

WATER WELL DRILLERS LOG

June 19 1974 *Chater Reeves* *Wilkinson*  
 date well completed firm name county well located

LANDOWNER: *James Ross*  
*Britchard*  
*Rt 1, Coashy -*  
 (mailing address)

description of formations encountered	from	to
<i>Clay</i>	<i>0</i>	<i>12</i>
<i>sand &amp; gravel</i>	<i>12</i>	<i>27</i>
<i>blue chalk</i>	<i>27</i>	<i>62</i>
<i>fine blue sand</i>	<i>62</i>	<i>75</i>
<i>coarse sand</i>	<i>75</i>	<i>82</i>

WELL LOCATION:  
 sec. *25* *4* N R *1* W  
*9* miles *W* *SW* of *Prattville*  
 (distance) (direction) (nearest town)

WELL PURPOSE: *same*  
 (home, irrigation, municipal, industrial)

- WELL COMPLETION DATA:
- (1) diameter (inches) *4*
  - (2) total depth (feet) *82*
  - (3) static water level (feet) *55* below top of ground.
  - (4) casing *Plast. bottom*  
 (material) (depth)
  - (size) If telescope see back.
  - (5) screen *6'* *76'*  
 (length) (depth to top)
  - 4"* *Plast*  
 (size) (material)
  - (6) pump *1/2 Sub* *10*  
 (HP) (yield gpm)
  - elect*  
 (type power)
  - (7) electric log *No.*  
 (yes or no)
  - (organization running log)

(8) how well bottom plugged  
*wooden plug*

DRILLERS REMARKS:  
*New location*

CODED

RECEIVED  
 RECEIVED


FEB 16 1975

If well telescopes please sketch and show depths.

GROUND LEVEL

1000  
1000  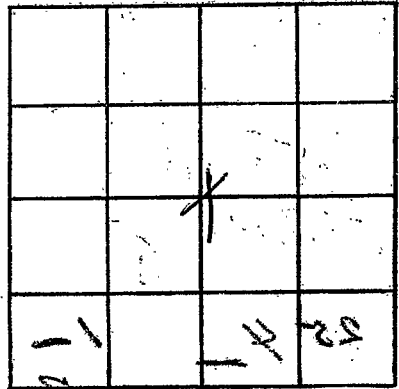
SECTION 25

Please indicate well location X.

ADDITIONAL INFORMATION

Handwritten notes and scribbles on the additional information lines.

If more than one screen, show locations of each on sketch.