

MISSISSIPPI DEPARTMENT OF NATURAL RESOURCES

Bureau of Land and Water Resources

Southport Mall

P.O. Box 10631

Jackson, Mississippi 39209

WATER WELL DRILLERS LOG

WILKINSON
C 24
9-15-81

CODED

9-15-81 date well completed Rayborn Drilling & Land Co. firm name Wilkinson county well located

LANDOWNER:	description of formations encountered	from	to
Wilcox Drillers, Inc	Top soil	0	2
Natchez, MS 39120 (drilling address)	Humus	2	40
WELL LOCATION: sec 6 T 40 N R 1 E 8 miles Nw of Rosetta (distance) (direction) (nearest town)	Sand	40	80
WELL PURPOSE: (home, irrigation, municipal, industrial)	702' @ RA W NIL		405' @
WELL COMPLETION DATA:	RA W E/L		
(1) diameter (inches) 3"			
(2) total depth (feet) 80'			
(3) static water level (feet) 15' below top of ground.			
(4) casing PVC, 60' (material), (depth) 3" (size) if telescope see back.			
(5) screen 20', 60' (length), (depth to top) 3" (size), PVC (material)			
(6) pump 50 Gpm (HP), (yield gpm) (type power)			
(7) electric log no (yes or no) (organization running log)			
(8) how well bottom plugged well plug			
DRILLERS REMARKS:			


CODED

DEPT. OF NATURAL RESOURCES
BUREAU OF LAND & WATER RESOURCES

RECEIVED
SEP 18 1981

If well telescopes please sketch and show depths.

GROUND LEVEL

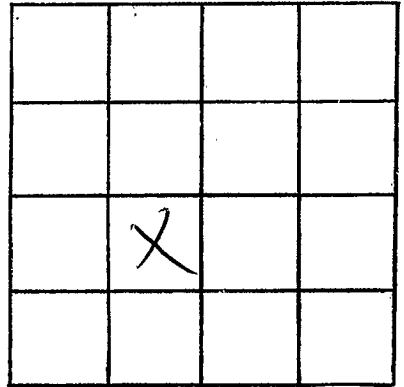

SECTION 6

Please indicate well location X.

ADDITIONAL INFORMATION



If more than one screen, show locations of each on sketch.